

1993

COMMISSION

BRANCH COUNTY REMONUMENTATION CORNER

LAND CORNER RECORDATION CERTIFICATE

Filing Requirement of Act 74, Mich. P.A. 1970

For corners in

BRANCH (County)	Located In:	Corner Code #
1. Public Land Survey	T 7 S R 6 W	E - 2
	T R	
	T R	
	T R	
2. Property Controlling in Section	S T R	
	S T R	
3. Miscellaneous Property in Sec.	S T R	
	S T R	

268

REGISTER OF DEEDS


John J. Moore

93 DEC 27 AM 10:07

REC'D FOR RECORD
STATE OF MICHIGAN
DIVISION OF DEEDS

Register of Deeds Stamp & File Number

- 4. Lot No. _____, Recorded Plat _____
- 5. Private Claims _____

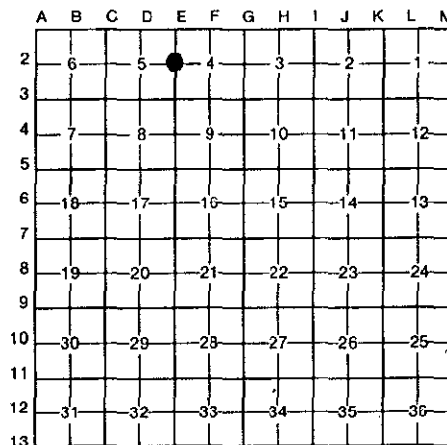

OVID TOWNSHIP
T7S, R6W

I, EDWARD R. REED, in a field survey on NOVEMBER 3, 19 93, do hereby certify that under requirements of P.A. 74, Michigan P.A. of 1970, the corner points mentioned in lines 1 and 2 above were in conformance with regulations and rules therefore as required in the current manual of survey instructions of the United States Department of the Interior, Bureau of Land Management or by a decree of a Court of Law and/or that the corner points mentioned in lines 3, 4 and 5 above were in conformance with the rules of the Michigan Board of Land Surveyors or by a Decree of a Court of Law; established, re-established, monumented, re-monumented, recovered, found as expressed below:

NOTE: Not more than 4 corners, all in the same town and range, may be recorded on this certificate.

A. Description of original monument and accessories and/or subsequent restoration:

QUARTER CORNER, SECTIONS 4/5, OVID TOWNSHIP, T7S, R6W

Nov., 1825. W. Broomfield, GLO Deputy Surveyor:

"40.00 Set Qtr Sec Post.

Beech 10 S51E 17 Beech 11 S68½W 24"

5/31/1878. M. Knowles, County Surveyor:

Knowles refers to a distance from this corner, but no description of corner monumentation is given on survey notes/remarks.

B. Description of corner evidence found and/or method applied in restoring or reestablishing corner:

Found stone 24" below road surface, along with pieces of "old" brick.

Set 1/2"x18" rebar iron rod with I.D. cap #7437, over stone, in monument box.

C. Description of monument for corner and accessories established to perpetuate locating the position of the corner:

1/2"x18" rebar iron rod with I.D. cap #7437, over stone, in monument box.

Round Wood Anchor Post, West 28.6' to east face.

Round Wood Anchor Post, East 34.1' to west face; fenceline runs east from anchor post.

14" Elm, N 30 E 63.20' to center of tree.

C/L south end of CMP driveway culvert, N 12 E 238.4'



This is accepted as a careful and faithful perpetuation of the position of the original corner.

Signed by *Edward R. Reed* Date 11/03/93

Surveyor's Michigan License No. 7437