

1993

BRANCH COUNTY REMONUMENTATION CORNER

COMMISSION

LAND CORNER RECORDATION CERTIFICATE

Filing Requirement of Act 74, Mich. P.A. 1970

For corners in

BRANCH (County)	Located In:	Corner Code #
1. Public Land Survey	T <u>7</u> S R <u>6</u> W	<u>E - 3</u>
	T _____ R _____	_____
	T _____ R _____	_____
	T _____ R _____	_____
2. Property Controlling in Section	S _____ T _____ R _____	_____
	S _____ T _____ R _____	_____
3. Miscellaneous Property in Sec.	S _____ T _____ R _____	_____
	S _____ T _____ R _____	_____

269


REGISTER OF DEEDS  
*Charles A. Robinson*

93 DEC 27 AM 10:07

REC'D FOR RECORD  
STATE OF MICHIGAN  
BRANCH COUNTY

Register of Deeds Stamp & File Number

- 4. Lot No. \_\_\_\_\_, Recorded Plat \_\_\_\_\_
- 5. Private Claims \_\_\_\_\_

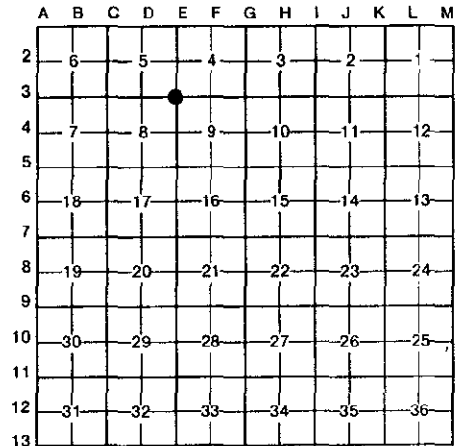

OVID TOWNSHIP  
T7S, R6W

I, EDWARD R. REED, in a field survey on NOVEMBER 3, 19 93, do hereby certify that under requirements of P.A. 74, Michigan P.A. of 1970, the corner points mentioned in lines 1 and 2 above were in conformance with regulations and rules therefore as required in the current manual of survey instructions of the United States Department of the Interior, Bureau of Land Management or by a decree of a Court of Law and/or that the corner points mentioned in lines 3, 4 and 5 above were in conformance with the rules of the Michigan Board of Land Surveyors or by a Decree of a Court of Law; established, re-established, monumented, re-monumented, recovered, found as expressed below:

NOTE: Not more than 4 corners, all in the same town and range, may be recorded on this certificate.

A. Description of original monument and accessories and/or subsequent restoration:

SECTION CORNER 4-5-8-9, OVID TWP., T7S, R6W.

GLO = Nov., 1825, W. Brookfield, Dep. Surveyor = " 80.00 Set post cor. sec 4, 5, 8 & 9. W Ash 8 N85½E 39, W Ash 8 S52-1/3W 39".

May, 1891; J. H. Bennett, 3/65 of County Surveyor's Records: "No notes given" for NE corner of Section 8.

Section Corner File card = No information.

B. Description of corner evidence found and/or method applied in restoring or reestablishing corner:

Proportioned actual and GLO distances from section corners North, South and West. Dug for any corner monument, but found nothing.

Set ½" x 18" rebar iron rod in monument box for corner at proportional distances.

C. Description of monument for corner and accessories established to perpetuate locating the position of the corner:

1½" x 18" rebar iron with I.D. cap, in monument box.  
 S 60 W 59.10' - Top center, telephone pedestal.  
 N 45 W 37.21' - Top center, telephone pedestal.  
 S 45 E 40.92' - Top center, telephone pedestal  
 N 42 W 32.6' - C/L west end CMP road culvert, N. side of road intersection.  
 5.5' south of C/L east-west road.  
 And is accepted as a careful and faithful reestablishment of the position of the original corner.

Signed by *Edward R. Reed*  
 Surveyor's Michigan License No. 7437



Date 11/03/93