

1993

COMMISSION

BRANCH COUNTY REMONUMENTATION CORNER
LAND CORNER RECORDATION CERTIFICATE
Filing Requirement of Act 74, Mich. P.A. 1970

For corners in

BRANCH (County)	Located In:	Corner Code #
1. Public Land Survey	T <u>7</u> S <u>R</u> 6 W	E - 4
	T _____ R _____	_____
	T _____ R _____	_____
	T _____ R _____	_____
2. Property Controlling in Section	S _____ T _____ R _____	_____
	S _____ T _____ R _____	_____
3. Miscellaneous Property in Sec.	S _____ T _____ R _____	_____
	S _____ T _____ R _____	_____
4. Lot No. _____, Recorded Plat _____		
5. Private Claims _____		


270

REC'D FOR RECORD
STATE OF MICHIGAN
BRANCH COUNTY

93 DEC 27 AM 10:07

Register of Deeds Stamp & File Number

I, EDWARD R. REED, in a field survey on November 2, 1993, do hereby certify that under requirements of P.A. 74, Michigan P.A. of 1970, the corner points mentioned in lines 1 and 2 above were in conformance with regulations and rules therefore as required in the current manual of survey instructions of the United States Department of the Interior, Bureau of Land Management or by a decree of a Court of Law and/or that the corner points mentioned in lines 3, 4 and 5 above were in conformance with the rules of the Michigan Board of Land Surveyors or by a Decree of a Court of Law; established, re-established, monumented, re-monumented, recovered, found as expressed below:

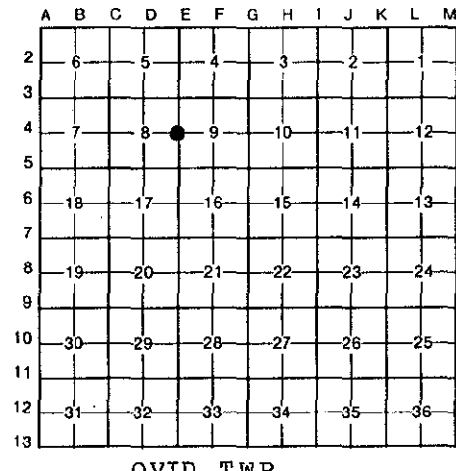

NOTE: Not more than 4 corners, all in the same town and range, may be recorded on this certificate.


A. Description of original monument and accessories and/or subsequent restoration:
 QUARTER SECTION CORNER 8-9, OVID TWP., T7S, R6W.
 GLO = Nov. 1825, W. BROOKFIELD, Dep. Surveyor: " 40.00 Set qr sec post.
 Beech 8 S 9 W 29, Beech 5 S 79 W 18 "
 May, 1891; J. H. BENNETT, 3/65 Co. Surveyor's Records: "Fd stone & deposit deep in the ground. Fences agreeing, set large stone & cut notch in top-with cobbles for deposit. Sycamore 24 N49½E 47, Butternut 20 S9½E 223."
 5/02/1968, E. R. REED: Fd. stone 16" deep, set 3/4" dia. steel pin over stone.

B. Description of corner evidence found and/or method applied in restoring or reestablishing corner:
 Fd. stone 12" deep with 3/4" steel pin over stone.
 Set ½" x 6" rebar iron rod with I.D. cap in monument box in place of steel pin and over stone.

C. Description of monument for corner and accessories established to perpetuate locating the position of the corner:
 ½" x 6" rebar iron rod with I.D. cap in monument box:
 West 28.20' - East face of wood corner post
 East 27.00' - Center of 14" Walnut.
 S 80 E 25.31' - Center of 18" Walnut.
 S 40 W 61.10' - Center of 20" Ash.
 N 20 E 160.6' - Center of 60" Maple

And is accepted as a careful and faithful perpetuation of the position of the original corner.

Signed by Edward R. Reed
 Surveyor's Michigan License No. 7437

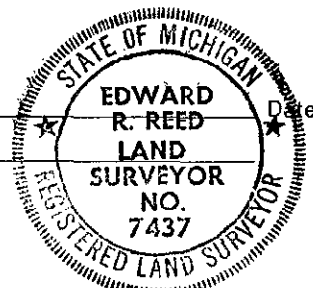

Date 11/02/93