

1993

COMMISSION

BRANCH COUNTY REMONUMENTATION CORNER  
LAND CORNER RECORDATION CERTIFICATE  
Filing Requirement of Act 74, Mich. P.A. 1970

For corners in

BRANCH (County)	Located In:	Corner Code #
1. Public Land Survey	T <u>7S</u> R <u>6 W</u>	<u>E-6</u>
	T _____ R _____	_____
	T _____ R _____	_____
	T _____ R _____	_____
2. Property Controlling in Section	S _____ T _____ R _____	_____
	S _____ T _____ R _____	_____
3. Miscellaneous Property in Sec.	S _____ T _____ R _____	_____
	S _____ T _____ R _____	_____
4. Lot No. _____, Recorded Plat _____		
5. Private Claims _____		


271

REC'D FOR RECORD  
 STATE OF MICHIGAN  
 BRANCH COUNTY  
 93 DEC 27 AM 10:07  
 REGISTER OF DEEDS  
*John J. Morrison*

Register of Deeds Stamp & File Number

I, EDWARD R. REED in a field survey on NOVEMBER 5, 1993, do hereby certify that under requirements of P.A. 74, Michigan P.A. of 1970, the corner points mentioned in lines 1 and 2 above were in conformance with regulations and rules therefore as required in the current manual of survey instructions of the United States Department of the Interior, Bureau of Land Management or by a decree of a Court of Law and/or that the corner points mentioned in lines 3, 4 and 5 above were in conformance with the rules of the Michigan Board of Land Surveyors or by a Decree of a Court of Law; established, re-established, monumented, re-monumented, recovered, found as expressed below:

**NOTE: Not more than 4 corners, all in the same town and range, may be recorded on this certificate.**

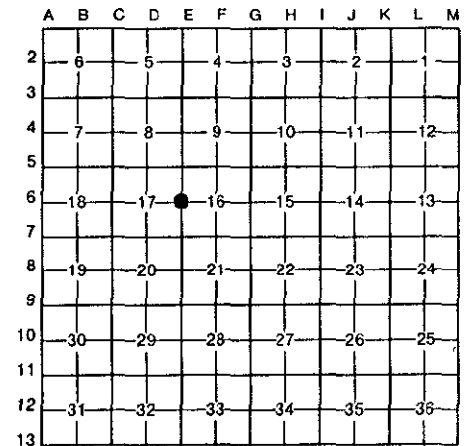

OVID TOWNSHIP  
T7S, R6W

A. Description of original monument and accessories and/or subsequent restoration:

QUARTER CORNER, SECTIONS 16/17, OVID TOWNSHIP, T7S, R6W.

NOV. 1825: W. Brookfield, GLO Dep. Surveyor:  
 "40.00 Set qr sec post,  
 Beech 8 S 64 W 6;  
 Beech 7, N 72½ E 20½."

No other information.

B. Description of corner evidence found and/or method applied in restoring or reestablishing corner:

Found large flat stone below original earth grade, 18" below road surface. Removed stone and found remains of old wood stake below stone location.


Set ½" x 18" rebar iron with I.D. cap in monument box, over wood stake point.

C. Description of monument for corner and accessories established to perpetuate locating the position of the corner:

Rebar iron stake as noted above.  
 West 31.15' - E. face, square wood anchor post.  
 East 27.20' - W. face, steel channel anchor post.  
 S 15 W 98.60' - Nail & washer, W. side 40" Maple.  
 S 25 W 70.15' - Nail & washer, W. side 12" Aspen.  
 N 20 W 65.20' - Nail & washer, E. side 10" Elm.

And is accepted as a careful and faithful perpetuation of the position of the original corner.

Signed by *Edward R. Reed*  
 Surveyor's Michigan License No. 7437

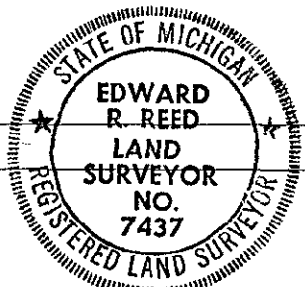

Date 11/05/93