

SURVEY & REMONUMENTATION

MAR 21 1997

COMMISSION

BRANCH COUNTY REMONUMENTATION CORNER LAND CORNER RECORDATION CERTIFICATE Filing Requirement of Act 74, Mich. P.A. 1970

For corners in

BRANCH <small>(County)</small>	Located In:	Corner Code #	
OVID TWP.		H-11	
1. Public Land Survey	T <u>7S</u> R <u>6W</u>		
	T ___ R ___		
	T ___ R ___		
	T ___ R ___		
2. Property Controlling in Section	S ___ T ___ R ___		
	S ___ T ___ R ___		
3. Miscellaneous Property in Sec.	S ___ T ___ R ___		
	S ___ T ___ R ___		
4. Lot No. _____, Recorded Plat _____			
5. Private Claims _____			

STATE OF MICHIGAN
Branch County
Recorded

12-30-1996 14:10:59

Linda Lee Mathews-Mathews

Liber **00003** Page **0102**

Register of Deeds Stamp & File Number

I, Edward W. Reed, in a field survey on OCTOBER 11, 19 96, do hereby certify that under requirements of P.A. 74, Michigan P.A. of 1970, the corner points mentioned in lines 1 and 2 above were in conformance with regulations and rules therefore as required in the current manual of survey instructions of the United States Department of the Interior, Bureau of Land Management or by a decree of a Court of Law and/or that the corner points mentioned in lines 3, 4 and 5 above were in conformance with the rules of the Michigan Board of Land Surveyors or by a Decree of a Court of Law; established, re-established, monumented, re-monumented, recovered, found as expressed below:

NOTE: Not more than 4 corners, all in the same town and range, may be recorded on this certificate.

	A	B	C	D	E	F	G	H	I	J	K	L	M
2	6	5	4	3	2	1							
3													
4	7	8	9	10	11	12							
5													
6	16	17	18	15	14	13							
7													
8	19	20	21	22	23	24							
9													
10	30	29	28	27	26	25							
11													
12	31	32	33	34	35	36							
13													

A. Description of original monument and accessories and/or subsequent restoration:


- QUARTER CORNER COMMON TO SECTIONS 27 & 34, T7S, R6W, OVID TWP, BRANCH COUNTY, MI
- 1825: BROOKFIELD, DEP. SURVEYOR, CORNER SET
- 1910: W. COX, DEP. SURVEYOR, FOUND OLD STAKE, PUT BRICK AROUND
- 1941: R. TERRILL, FOUND MINUTE BITS OF CHARCOAL BUT NO OTHER EVIDENCE OF CORNER
RESET CORNER, SET 1/2" x 24" REINFORCING ROD & BRICK
- OLD NOTES INDICATE FOUND 1/2" REINFORCING ROD & BRICK, SET 3/4" GAS PIPE OVER STONE
- 1963: D. HOOTH, MSHD SURVEY CHIEF, FOUND 3/4" STEEL PIPE

B. Description of corner evidence found and/or method applied in restoring or reestablishing corner:

- FOUND IRON PIPE
- SET 1/2" X 12" REBAR INSIDE WITH REMONUMENTATION CAP
- SET CAST IRON BOX FLUSH WITH ROAD SURFACE

ACCEPTED BY THE BRANCH COUNTY SURVEY PEER GROUP AS THE OFFICIAL CORNER UNDER MICHIGAN PUBLIC ACT 345 OF 1990 AT A MEETING HELD ON Nov. 13, 1996

E. R. Reed Co. Rep.
E. R. REED

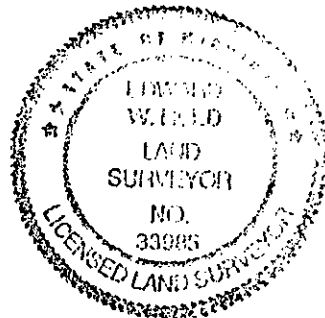

C. Description of monument for corner and accessories established to perpetuate locating the position of the corner:

- 1/2" X 12" REBAR WITH REMONUMENTATION CAP IN CAST IRON BOX
 - N71E 78.7' TO FACE OF POWER POLE
 - 138.3' WEST OF WEST WALL OF OLD STICKAN HOUSE
 - 6.6' NORTH OF SOUTH EDGE ROAD PAVEMENT
 - N72W 149.1' TO FACE OF POWER POLE
- AND IS ACCEPTED AS A CAREFUL AND FAITHFUL PERPETUATION OF THE POSITION OF THE ORIGINAL CORNER.

Signed by *Edward W. Reed* Date OCTOBER 11, 1996
 Surveyor's Michigan License No. 33985