

BRANCH COUNTY REMONUMENTATION CORNER

LAND CORNER RECORDATION CERTIFICATE

Filing Requirement of Act 74, Mich. P.A. 1970

For corners in

BRANCH

(County)

Located In:

Corner Code ##

1. Public Land Survey

T 7S R 6W

I-1

2. Property Controlling in Section

S T R

3. Miscellaneous Property in Sec.

S T R

4. Lot No. , Recorded Plat
5. Private Claims

REGISTRAR OF DEEDS
[Signature]

94 MAR 10 AM 9:48

REC'D FOR RECORD
STATE OF MICHIGAN
BRANCH COUNTY

II 286

Register of Deeds Stamp & File Number

Grid table with columns A-M and rows 1-13. A dot is marked at row 1, column I.

I, EDWARD W. REED, in a field survey on JANUARY 24, 1993, do hereby certify that under requirements of P.A. 74, Michigan P.A. of 1970, the corner points mentioned in lines 1 and 2 above were in conformance with regulations and rules therefore as required in the current manual of survey instructions of the United States Department of the Interior, Bureau of Land Management or by a decree of a Court of Law and/or that the corner points mentioned in lines 3, 4 and 5 above were in conformance with the rules of the Michigan Board of Land Surveyors or by a Decree of a Court of Law; established, re-established, monumented, re-monumented, recovered, found as expressed below:

NOTE: Not more than 4 corners, all in the same town and range, may be recorded on this certificate.

A. Description of original monument and accessories and/or subsequent restoration:

I-1, NORTH CORNER COMMON TO SECTIONS 2 & 3, T7S, R6W, OVID TOWNSHIP.

GLO NOTES: Set post 37 links east of Coldwater corner.

1878: M. KNOWLES, County Surveyor: Found stake, .37 east of corner 34-35, Coldwater Twp., planted stake & stone and stones around.

1963: RUSSELL ROON, Survey Chief, M.S.H.D., Found 3/8" iron rod near surface of Blacktop, Set monument box.

1977: E. R. REED, County Surveyor, Found iron rod in monument box.

B. Description of corner evidence found and/or method applied in restoring or reestablishing corner:

Found iron pipe and iron rod in CI-monument box using witness of M.S.H.D. & E.R. REED.


Set 1/2" iron inside of pipe with "BRANCH COUNTY REMONUMENTATION MARKER"

C. Description of monument for corner and accessories established to perpetuate locating the position of the corner:

REMONUMENTATION CAPPED IRON IN CI-MONUMENT BOX.

- Due West 37.9', Coldwater corner
Due West 16', C/L North-south road
N 12 E 66.5', Telephone Pedestal
N 36 E 47.7', Telephone Pedestal
N 60 W 69.1', Power Pole.

And is accepted as a careful and faithful perpetuation of the position of the original corner.

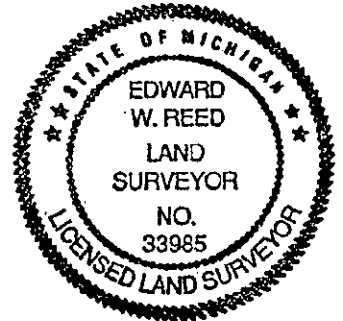

Signed by [Signature]
Surveyor's Michigan License No. 33985

Date JANUARY 24, 1994