

BRANCH COUNTY REMONUMENTATION PROGRAM

LAND CORNER RECORDATION CERTIFICATE

Filing Requirement of Act 74, Mich. P.A. 1970

REGISTER OF DEEDS
John A. Harrison

94 MAR 10 AM 9:48

REC'D FOR RECORD
STATE OF MICHIGAN
BRANCH COUNTY

For corners in

BRANCH
(County)

Located In:

Corner Code ##

- 1. Public Land Survey T 7S R 6W I-2
 T _____ R _____
 T _____ R _____
 T _____ R _____
- 2. Property Controlling S _____ T _____ R _____
 in Section S _____ T _____ R _____
- 3. Miscellaneous S _____ T _____ R _____
 Property in Sec. S _____ T _____ R _____

II 282

Register of Deeds Stamp & File Number

- 4. Lot No. _____, Recorded Plat _____
- 5. Private Claims _____

	A	B	C	D	E	F	G	H	I	J	K	L	M
2	6		5		4		3	●	2		1		
3													
4	7		8		9		10		11		12		
5													
6	13		17		16		15		14		13		
7													
8	19		20		21		22		23		24		
9													
10	30		29		28		27		26		25		
11													
12	31		32		33		34		35		36		
13													

I, EDWARD W. REED, in a field survey on JANUARY 24, 19 94, do hereby certify that under requirements of P.A. 74, Michigan P.A. of 1970, the corner points mentioned in lines 1 and 2 above were in conformance with regulations and rules therefore as required in the current manual of survey instructions of the United States Department of the Interior, Bureau of Land Management or by a decree of a Court of Law and/or that the corner points mentioned in lines 3, 4 and 5 above were in conformance with the rules of the Michigan Board of Land Surveyors or by a Decree of a Court of Law; established, re-established, monumented, re-monumented, recovered, found as expressed below:

NOTE: Not more than 4 corners, all in the same town and range, may be recorded on this certificate.

A. Description of original monument and accessories and/or subsequent restoration:

I-2 QUARTER SECTION CORNER COMMON TO SECTIONS 2 & 3, T7S, R6W, OVID

GLO NOTES: 40.00 north, set quarter section post
 1892 I.D. MINER, County Surveyor: Found drain tile & stone.
 1963 RUSSELL ROON, Survey Chief M.S.H.D.: Found large pointed stone 2½' below road, raised with 3/4" pipe, set monument box.
 1977 E.R. REED, County Surveyor: Found pipe over stone in monument box.

B. Description of corner evidence found and/or method applied in restoring or reestablishing corner:


Found iron pipe in CI-Monument box fitting witness of M.S.H.D. & Reed.
 Set ½" iron inside of pipe with "BRANCH COUNTY REMONUMENTATION MARKER"

C. Description of monument for corner and accessories established to perpetuate locating the position of the corner:

REMONUMENTATION CAPPED IRON IN CI-MONUMENT BOX

- S 89 W 41.2', Power Pole
- S 44 E 63.5', 54" Willow
- N 15 W 101.1', Telephone Pedestal
- S 26 W 100.5', Telephone Pedestal
- N 55 W 75.5', 30" Maple

And is accepted as a careful and faithful perpetuation of the position of the original corner.

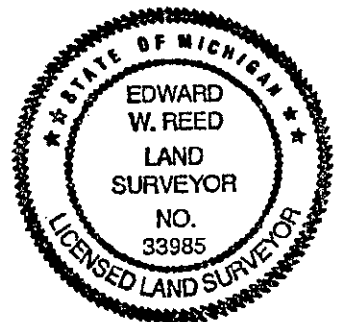

Signed by *Edward W. Reed*
 Surveyor's Michigan License No. 33985

Date JANUARY 24, 1994