

BRANCH COUNTY REMONUMENTATION CORNER
LAND CORNER RECORDATION CERTIFICATE
Filing Requirement of Act 74, Mich. P.A. 1970

REGISTER OF DEEDS
John DeWitt

94 MAR 10 AM 9:48

REC'D FOR RECORD
STATE OF MICHIGAN
BRANCH COUNTY

For corners in
BRANCH

(County)

Located In:

Corner Code #

- 1. Public Land Survey T 7S R 6W I-3
 T R
 T R
 T R
- 2. Property Controlling S T R
 in Section S T R
- 3. Miscellaneous S T R
 Property in Sec. S T R

II 283

Register of Deeds Stamp & File Number

- 4. Lot No. _____, Recorded Plat _____
- 5. Private Claims _____

	A	B	C	D	E	F	G	H	I	J	K	L	M
2	6		5		4		3		2		1		
3									●				
4	7		8		9		10		11		12		
5													
6	13		17		16		15		14		13		
7													
8	19		20		21		22		23		24		
9													
10	30		29		28		27		26		25		
11													
12	31		32		33		34		35		36		
13													

I, EDWARD W. REED, in a field survey on JANUARY 26, 19 94, do hereby certify that under requirements of P.A. 74, Michigan P.A. of 1970, the corner points mentioned in lines 1 and 2 above were in conformance with regulations and rules therefore as required in the current manual of survey instructions of the United States Department of the Interior, Bureau of Land Management or by a decree of a Court of Law and/or that the corner points mentioned in lines 3, 4 and 5 above were in conformance with the rules of the Michigan Board of Land Surveyors or by a Decree of a Court of Law; established, re-established, monumented, re-monumented, recovered, found as expressed below:

NOTE: Not more than 4 corners, all in the same town and range, may be recorded on this certificate.

A. Description of original monument and accessories and/or subsequent restoration:

SECTION CORNER COMMON TO SECTIONS 2,3,10 & 11, T7S,R6W, OVID TWP.

GLO NOTES: Corner post

1892 - I.D.MINER, County Surveyor: Set iron fire grate to agree with Bennett's notes.

OLD SECTION CORNER FILE: "iron fire grate"

1963 - RUSSELL ROON, Survey chief, M.S.H.D.: Found 5/8" pin flush with surface of blacktop road. Set CI-Monument box.

B. Description of corner evidence found and/or method applied in restoring or reestablishing corner:

Found iron rod in CI-monument box.

Set 1/2" rebar iron with "BRANCH COUNTY REMONUMENTATION MARKER" over top of old iron in CI-monument box.

C. Description of monument for corner and accessories established to perpetuate locating the position of the corner:


Capped rebar iron with Remonumentation marker #33985 as noted above

Telephone pedestal N 38 E 65.4'

Power pole S 69 E 78.1'

Telephone pedestal N 16 W 93.5'

And is accepted as a careful and faithful perpetuation of the position of the original corner.

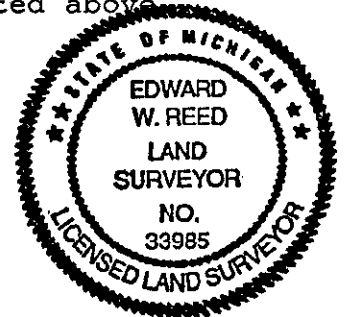

Signed by *Edward W. Reed*
Surveyor's Michigan License No. 33985

Date JANUARY 26, 1994