

BRANCH COUNTY REMONUMENTATION CORNER  
LAND CORNER RECORDATION CERTIFICATE  
Filing Requirement of Act 74, Mich. P.A. 1970

For corners in

BRANCH (County)	Located In:	Corner Code #
1. Public Land Survey	T <u>7S</u> R <u>6W</u>	<u>I-7</u>
	T _____ R _____	_____
	T _____ R _____	_____
	T _____ R _____	_____
2. Property Controlling in Section	S _____ T _____ R _____	_____
	S _____ T _____ R _____	_____
3. Miscellaneous Property in Sec.	S _____ T _____ R _____	_____
	S _____ T _____ R _____	_____

REC'D FOR RECORD  
STATE OF MICHIGAN  
BRANCH COUNTY

94 MAR 10 AM 9:48

REGISTER OF DEEDS

II 285

Register of Deeds Stamp & File Number

4. Lot No. \_\_\_\_\_, Recorded Plat \_\_\_\_\_

5. Private Claims \_\_\_\_\_

	A	B	C	D	E	F	G	H	I	J	K	L	M
2	6		5		4		3		2		1		
3													
4	7		8		9		10		11		12		
5													
6	18		17		16		15		14		13		
7													
8	19		20		21		22		23		24		
9													
10	30		29		28		27		26		25		
11													
12	31		32		33		34		35		36		
13													

I, EDWARD W. REED, in a field survey on JANUARY 26, 19 94, do hereby certify that under requirements of P.A. 74, Michigan P.A. of 1970, the corner points mentioned in lines 1 and 2 above were in conformance with regulations and rules therefore as required in the current manual of survey instructions of the United States Department of the Interior, Bureau of Land Management or by a decree of a Court of Law and/or that the corner points mentioned in lines 3, 4 and 5 above were in conformance with the rules of the Michigan Board of Land Surveyors or by a Decree of a Court of Law; established, re-established, monumented, re-monumented, recovered, found as expressed below:

NOTE: Not more than 4 corners, all in the same town and range, may be recorded on this certificate.

A. Description of original monument and accessories and/or subsequent restoration:  
SECTION CORNER COMMON TO SECTIONS 14, 15, 22 & 23, T7S, R6W, OVID TWP.

GLO NOTES: 80.00, set post corner  
OLD SECTION CORNER FILE: "iron"  
1963 - RUSSELL ROON, Survey chief, M.S.H.D.: found 5/8" iron pin, set CI-monument box.  
1965 - RUSSELL ROON, Survey chief, M.S.H.D: found east 1/4 corner section 15, 2646.63' north of SE corner section 15  
1975 - EDWARD R. REED, County Surveyor: found iron rod in monument box.

B. Description of corner evidence found and/or method applied in restoring or reestablishing corner:


Found iron pipe with PK nail inside of CI-monument box.

Set 1/2" rebar iron with "BRANCH COUNTY REMONUMENTATION MARKER" inside of existing pipe in CI-monument box.

C. Description of monument for corner and accessories established to perpetuate locating the position of the corner:  
1/2" rebar iron with "BRANCH COUNTY REMONUMENTATION MARKER" # 33985 as noted above.

OLD WITNESS: NW corner house, S 71 E 84.3'  
NEW WITNESS: Telephone pedestal N 78 E 52.0'  
Telephone pedestal S 75 W 37.2'  
16" twin maple, N 17 W 99.9'

And is accepted as a careful and faithful perpetuation of the position of the original corner.

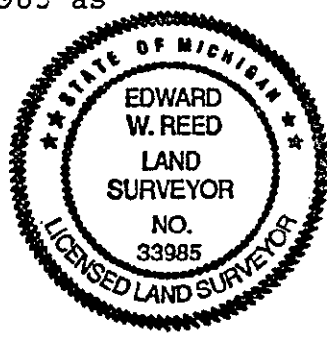

Signed by Edward W. Reed Date JANUARY 26, 1994  
Surveyor's Michigan License No. 33985