SURVEY &
MONUMENTATION

JAN 2 3 1996

COMMISSION

BRANCH COUNTY REMONUMENTATION CORNER

LAND CORNER RECORDATION CERTIFICATE

Filing Requirement of Act 74, Mich. P.A. 1970

For corners in BRANCH (County)

Liber 00003 Page 0038
STATE OF MICHIGAN
Branch County
Recorded

09-28-1995 10:22:11

Linda Lee Morrison-Mathews
REGISTER OF DEEDS

Register of Deeds Stamp & File Number

	Located In:	Corner Code ##
OVID TWP.		
1. Public Land Survey	T 7 S R 6 W	I-8
	T ___ R ___	
	T ___ R ___	
	T ___ R ___	
2. Property Controlling	S ___ T ___ R ___	
in Section	S ___ T ___ R ___	
3. Miscellaneous	S ___ T ___ R ___	
Property in Sec.	S ___ T ___ R ___	

4. Lot No. _____ , Recorded Plat _____
5. Private Claims _____

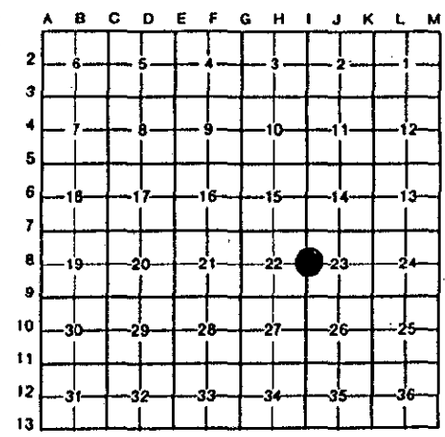

I, Edward W. Reed, in a field survey on August 21, 19 95, do hereby certify that under requirements of P.A. 74, Michigan P.A. of 1970, the corner points mentioned in lines 1 and 2 above were in conformance with regulations and rules therefore as required in the current manual of survey instructions of the United States Department of the Interior, Bureau of Land Management or by a decree of a Court of Law and/or that the corner points mentioned in lines 3, 4 and 5 above were in conformance with the rules of the Michigan Board of Land Surveyors or by a Decree of a Court of Law; established, re-established, monumented, re-monumented, recovered, found as expressed below:

NOTE: Not more than 4 corners, all in the same town and range, may be recorded on this certificate.

A. Description of original monument and accessories and/or subsequent restoration:

QUARTER CORNER COMMON TO SECTIONS 22 & 23, T7S, R6W, OVID TWP., BRANCH COUNTY, MI.

1825: Wm. Brookfield-GLO Dep. Surveyor-set corner
1894: I. D. Miner, County Surveyor-sleigh shoe under boulder
1964: E. R. Reed, County Surveyor-"Plat of Shady Oaks Subdivision No. #2" tied to corner
1972: D. Boone, Surveyor-survey
1981: E. R. Reed, County Surveyor,-old iron preserved by County Road Commission in road Reconstruction - 1" iron rod in cast iron box, recorded L.C.R.#II-0037

B. Description of corner evidence found and/or method applied in restoring or reestablishing corner:

Found 1" solid iron, could not remove
Set 1/2" x 4" iron over top with remonumentation cap

ACCEPTED BY THE BRANCH COUNTY SURVEY PEER GROUP AS THE OFFICIAL CORNER UNDER MICHIGAN PUBLIC ACT 345 OF 1990 AT A MEETING HELD ON 9-13-95
E. R. Reed, Co Rep.

C. *Description of monument for corner and accessories established to perpetuate locating the position of the corner:*

N78°E 34.0'-power pole
W 29.7'-to near face of square wood anchor post
S32E 59.7'-to center of 12" maple
S32°W 64.5'-to near face of telephone pole

STATE OF MICHIGAN
EDWARD W. REED
LAND SURVEYOR
NO. 33985
LICENSED LAND SURVEYOR

And is accepted as a careful and faithful perpetuation of the position of the original corner.

Signed by Edwin W. Reed Date August 21, 1995

Surveyor's Michigan License No. 33985

Edward W. Reed

FORM APPROVED BY MICHIGAN STATE BOARD OF LAND SURVEYORS, JAN. 28, 1971
REVISED MAY 14, 1975
REVISED JAN., 1983