

SURVEY & REMONUMENTATION

MAR 21 1997

BRANCH COUNTY REMONUMENTATION CORNER, Liber 00003 Page 0103
 LAND CORNER RECORDATION CERTIFICATE
 Filing Requirement of Act 74, Mich. P.A. 1970

For corners in COMMISSION

BRANCH (County)	Located In:	Corner Code -#
OVIND TWP.		
1. Public Land Survey	T <u>7</u> S R <u>6</u> W	<u>K-11</u>
	T _____ R _____	_____
	T _____ R _____	_____
	T _____ R _____	_____
2. Property Controlling in Section	S _____ T _____ R _____	_____
	S _____ T _____ R _____	_____
3. Miscellaneous Property in Sec.	S _____ T _____ R _____	_____
	S _____ T _____ R _____	_____
4. Lot No. _____, Recorded Plat _____		
5. Private Claims _____		

STATE OF MICHIGAN
 Branch County
 Recorded

12-30-1996 14:11:05

Linda Lee Morrison-Mathews
 REGISTER OF DEEDS
 Register of Deeds Stamp & File Number

I, EDWARD W. REED, in a field survey on OCTOBER 25, 19 96, do hereby certify that under requirements of P.A. 74, Michigan P.A. of 1970, the corner points mentioned in lines 1 and 2 above were in conformance with regulations and rules therefore as required in the current manual of survey instructions of the United States Department of the Interior, Bureau of Land Management or by a decree of a Court of Law and/or that the corner points mentioned in lines 3, 4 and 5 above were in conformance with the rules of the Michigan Board of Land Surveyors or by a Decree of a Court of Law; established, re-established, monumented, re-monumented, recovered, found as expressed below:

NOTE: Not more than 4 corners, all in the same town and range, may be recorded on this certificate.


	A	B	C	D	E	F	G	H	I	J	K	L
2	6	5	4	3	2	1						
3												
4	7	8	9	10	11	12						
5												
6	18	17	16	15	14	13						
7												
8	19	20	21	22	23	24						
9												
10	30	29	28	27	26	25						
11												
12	31	32	33	34	35	36						
13												

A. Description of original monument and accessories and/or subsequent restoration:
 CORNER COMMON TO SECTIONS 25, 26, 35 & 36; T7S, R6W, OVID TWP., BRANCH COUNTY, MI
 1825: W. BROOKFIELD, DEP. SURVEYOR, CORNER SET
 1879: M. KNOWLES, COUNTY SURVEYOR, FOUND U.S. STAKE SET STONE & STONES AROUND
 1927: E.L. MINER, COUNTY SURVEYOR, PLAT OF "ECHTINAW HOMESTEAD" TIED TO CORNER
 1938: E.L. MINER, COUNTY SURVEYOR, NOTES OF SURVEY INDICATE "FOUND ANCHOR POST AT SE CORNER, SECTION 26, SHOWN ME BY HENRY ECHTINAW" ALSO, PLAT OF "CEDAR BANK" TIED TO CORNER
 1990: ER REED, COUNTY SURVEYOR, WOOD ANCHOR POST, R.L.S. CAPPED 1/2" REBAR ON EAST SIDE, RECORDED L.C.R.C.#II-0145

B. Description of corner evidence found and/or method applied in restoring or reestablishing corner:
 FOUND 1/2" IRON & ERR CAP ON EAST SIDE OF 12" WOOD ANCHOR POST
 REMOVED ERR CAP AND PLACED REMONUMENTATION CAP & CARSONITE MARKER ON SOUTH SIDE

ACCEPTED BY THE BRANCH COUNTY SURVEY PEER GROUP AS THE OFFICIAL CORNER UNDER MICHIGAN PUBLIC ACT 345 OF 1990 AT A MEETING HELD ON Nov. 13, 1996

E. R. Reed, Co. Rep.
 E.R. REED

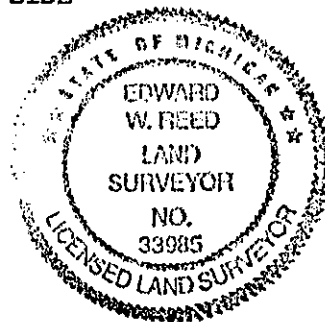

C. Description of monument for corner and accessories established to perpetuate locating the position of the corner:
 1/2" IRON WITH REMONUMENTATION CAP IN CAST IRON BOX
 FENCELINE RUNNING N-S-E
 SOUTH 13.2' WOOD POST IN FENCELINE
 N80W 3.35' TO PK NAIL IN NORTH SIDE OF 32" ASH
 AND IS ACCEPTED AS A CAREFUL AND FAITHFUL PERPETUATION OF THE POSITION OF THE ORIGINAL CORNER.

Signed by Edward W. Reed Date OCTOBER 25, 1996
 Surveyor's Michigan License No. EDWARD W. REED 33985