

SURVEY & REMONUMENTATION

APR 26 1995

ACCEPTED BY THE BRANCH COUNTY SURVEY PEER GROUP AS THE OFFICIAL CORNER UNDER MICHIGAN PUBLIC ACT 345 OF 1990 AT A MEETING HELD ON 12-16-94

BRANCH COUNTY REMONUMENTATION CORNER
COMMISSION
LAND CORNER RECORDATION CERTIFICATE
Filing Requirement of Act 74, Mich. P.A. 1970

E.R. Roel, Co. Rep.

For corners in

Branch _____ (County)	Located In:	Corner Code =#
OID TOWNSHIP		
1. Public Land Survey	T <u>7</u> S R <u>6</u> W	M-11
	T _____ R _____	_____
	T _____ R _____	_____
	T _____ R _____	_____
2. Property Controlling in Section	S _____ T _____ R _____	_____
	S _____ T _____ R _____	_____
3. Miscellaneous Property in Sec.	S _____ T _____ R _____	_____
	S _____ T _____ R _____	_____

STATE OF MICHIGAN
Branch County
Recorded

12-28-1994 15:08:39

Linda L. [unclear] - Nathan [unclear]
Register of Deeds, Stamp & File Number
REGISTER OF DEEDS

4. Lot No. _____, Recorded Plat _____
5. Private Claims _____

I, Edward W. Reed, in a field survey on December 12, 19 94, do hereby certify that under requirements of P.A. 74, Michigan P.A. of 1970, the corner points mentioned in lines 1 and 2 above were in conformance with regulations and rules therefore as required in the current manual of survey instructions of the United States Department of the Interior, Bureau of Land Management or by a decree of a Court of Law and/or that the corner points mentioned in lines 3, 4 and 5 above were in conformance with the rules of the Michigan Board of Land Surveyors or by a Decree of a Court of Law; established, re-established, monumented, re-monumented, recovered, found as expressed below:

NOTE: Not more than 4 corners, all in the same town and range, may be recorded on this certificate.

	A	B	C	D	E	F	G	H	I	J	K	L	M
2	6	5	4	3	2	1							
3													
4	7	8	9	10	11	12							
5													
6	18	17	16	15	14	13							
7													
8	19	20	21	22	23	24							
9													
10	30	29	28	27	26	25							
11													
12	31	32	33	34	35	36							
13													

A. Description of original monument and accessories and/or subsequent restoration:


Southeast corner of Section 25 and Northeast corner, Section 36, Town 7 South, Range 6 West, Ovid Township, Branch County, Michigan.
1825: Brookfield, corner set
1880: Knowles, corner not readily identified
1889: Hamilton, found both US stumps of Tamarack, set oak stake

B. Description of corner evidence found and/or method applied in restoring or reestablishing corner:

Unable to locate oak stake.
Reset original position using GLO offset of 104 links, proportionate distance of corners South and ancient fenceline North
Set 1/2" x 18" rebar; 1" x 30" solid iron below
Set remonumentation cap and cast iron box

C. Description of monument for corner and accessories established to perpetuate locating the position of the corner:

1/2" rebar as noted above:
N 20° W 63.09' telephone pedestal
North 58.68' square wood anchor post
S 34° E 20.80' nail and washer 2' up west side of 14" walnut
Due W 20.1' Centerline of road South

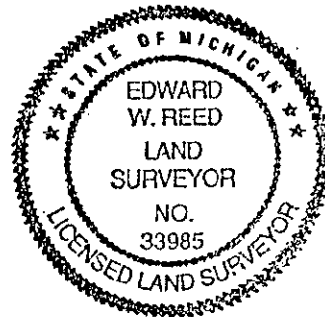

Signed by Edward W. Reed Date December 12, 1994

Surveyor's Michigan License No. 33985

EDWARD W. REED