

# SURVEY & REMONUMENTATION

ACCEPTED BY THE BRANCH COUNTY SURVEY PEER GROUP AS THE OFFICIAL CORNER UNDER MICHIGAN PUBLIC ACT 345 OF 1990 AT A MEETING HELD ON 12-16-94

APR 26 1995

BRANCH COUNTY REMONUMENTATION CORNER  
LAND COMMISSION CERTIFICATE  
Filing Requirement of Act 74, Mich. P.A. 1970

E. R. Reed C. Rep.

For corners in

<u>Branch</u> <small>(County)</small>	Located In:	Corner Code = #	
1. Public Land Survey	T <u>7</u> S R <u>6</u> W	<u>M-12</u>	
	T _____ R _____	_____	
	T _____ R _____	_____	
	T _____ R _____	_____	
2. Property Controlling in Section	S _____ T _____ R _____	_____	
	S _____ T _____ R _____	_____	
3. Miscellaneous Property in Sec.	S _____ T _____ R _____	_____	
	S _____ T _____ R _____	_____	

STATE OF MICHIGAN  
Branch County  
Recorded

12-28-1994 15:08:48

12-28-1994 15:08:48  
REGISTER OF DEEDS

Register of Deeds Stamp & File Number

4. Lot No. \_\_\_\_\_, Recorded Plat \_\_\_\_\_  
5. Private Claims \_\_\_\_\_

	A	B	C	D	E	F	G	H	I	J	K	L	M
2	6	5	4	3	2	1							
3													
4	7	8	9	10	11	12							
5													
6	18	17	16	15	14	13							
7													
8	19	20	21	22	23	24							
9													
10	30	29	28	27	26	25							
11													
12	31	32	33	34	35	36							
13													

I, Edward W. Reed, in a field survey on August 24, 1994, do hereby certify that under requirements of P.A. 74, Michigan P.A. of 1970, the corner points mentioned in lines 1 and 2 above were in conformance with regulations and rules therefore as required in the current manual of survey instructions of the United States Department of the Interior, Bureau of Land Management or by a decree of a Court of Law and/or that the corner points mentioned in lines 3, 4 and 5 above were in conformance with the rules of the Michigan Board of Land Surveyors or by a Decree of a Court of Law; established, re-established, monumented, re-monumented, recovered, found as expressed below:

**NOTE: Not more than 4 corners, all in the same town and range, may be recorded on this certificate.**

A. Description of original monument and accessories and/or subsequent restoration:


East quarter corner, Section 36, Town 7 South, Range 6 West, Ovid Township, Branch County, Michigan  
1825: GLO notes, set corner  
1899: Bennett, found stone planted by Knowles

B. Description of corner evidence found and/or method applied in restoring or reestablishing corner:

Found 3/4" pipe with red brick on North side and South side, and agreeing with fenceline West  
Set 1/2" pipe inside of 3/4" pipe with remonumentation cap  
Set cast iron monument box 1" below grade

C. Description of monument for corner and accessories established to perpetuate locating the position of the corner:

1/2" rebar as noted above:  
West 28.7'-fence corner post  
North 66 West 22.76'-to north side of 16" walnut  
In line with fence running West  
In centerline of North and South road  
North 16° West 63.09-36" twin walnut south side  
North 28° East 42.6-old wood fence corner post  
North 35° East 47.8-8" fir

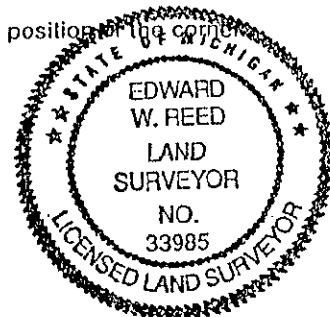

And is accepted as a careful and faithful perpetuation of the position of the original corner.

Signed by Edward W. Reed Date August 24, 1994  
Surveyor's Michigan License No. 33985