

# SURVEY & REMONUMENTATION

ACCEPTED BY THE BRANCH COUNTY SURVEY PEER GROUP AS THE OFFICIAL CORNER UNDER MICHIGAN PUBLIC ACT 348 OF 1990 AT A MEETING HELD ON 12-16-94

E.P. Reed Co. Rep.

APR 26 1995  
BRANCH COUNTY REMONUMENTATION CORNER  
STATE OF MICHIGAN  
LAND CORNER RECORDATION CERTIFICATE  
Branch County  
Recorded  
COMMISSION  
Filing Method provided by Act 74, Mich. P.A. 1970

For corners in

Branch _____ <small>(County)</small>	Located In:	Corner Code <del>##</del>
1. Public Land Survey	T <u>7</u> S R <u>6</u> W	<u>M-13</u>
	T _____ R _____	_____
	T _____ R _____	_____
	T _____ R _____	_____
2. Property Controlling in Section	S _____ T _____ R _____	_____
	S _____ T _____ R _____	_____
3. Miscellaneous Property in Sec.	S _____ T _____ R _____	_____
	S _____ T _____ R _____	_____

12-28-1994 15:08:56

Linda Lee Morrison-Mathews  
REGISTER OF DEEDS

Liber **00002** Page **0345**

Register of Deeds Stamp & File Number

4. Lot No. \_\_\_\_\_, Recorded Plat \_\_\_\_\_  
5. Private Claims \_\_\_\_\_


	A	B	C	D	E	F	G	H	I	J	K	L	M
2	6	5	4	3	2	1							
3													
4	7	8	9	10	11	12							
5													
6	18	17	16	15	14	13							
7													
8	19	20	21	22	23	24							
9													
10	30	29	28	27	26	25							
11													
12	31	32	33	34	35	36							
13													

I, Edward W. Reed, in a field survey on August 24, 19 94, do hereby certify that under requirements of P.A. 74, Michigan P.A. of 1970, the corner points mentioned in lines 1 and 2 above were in conformance with regulations and rules therefore as required in the current manual of survey instructions of the United States Department of the Interior, Bureau of Land Management or by a decree of a Court of Law and/or that the corner points mentioned in lines 3, 4 and 5 above were in conformance with the rules of the Michigan Board of Land Surveyors or by a Decree of a Court of Law; established, re-established, monumented, re-monumented, recovered, found as expressed below:

**NOTE: Not more than 4 corners, all in the same town and range, may be recorded on this certificate.**

A. Description of original monument and accessories and/or subsequent restoration:  
 Corner common to four Townships, Ovid, Kinderhook, Algansee, and California, Branch County, Michigan  
 1825: GLO  
 1880: Knowles-stone pipe, iron rod and stones around and above  
 1930: E. L. Miner-found red cedar stake, set 5/8" x 24" gas pipe and deposit of brick bats

B. Description of corner evidence found and/or method applied in restoring or reestablishing corner:  
 Found 1/2" pipe lying on side  
 Dug down and found 1/2" rebar and flagging (plastic/red)  
 Found several pieces of old wood "flat" stake  
 Set cap on existing 1/2" rebar  
 Set cast iron box

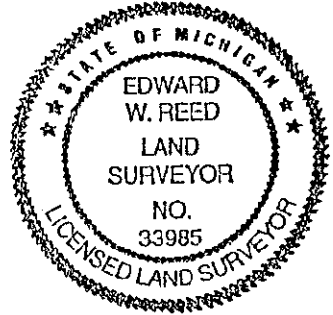

C. Description of monument for corner and accessories established to perpetuate locating the position of the corner:  
 South 84 West 20.0-6" pine  
 South 89 West 16.6-square wood anchor post  
 South 21 East 67.0'-to face of telephone pedestal  
 Due South 68.2'-North wall of house East  
 Due East 300.3'-West wall of house East

And is accepted as a careful and faithful perpetuation of the position of the original corner.

Signed by Edward W. Reed Date August 24, 1994  
 Surveyor's Michigan License No. 33985