

**BRANCH COUNTY REMONUMENTATION PROGRAM
LAND CORNER RECORDATION CERTIFICATE**
Filing Requirement of Act 74, Mich. P.A. 1970

STATE OF MICHIGAN
Branch County
Recorded

12-30-1999 11:03:19

Linda Lee Morrison-Mathews
REGISTER OF DEEDS

Liber **00004** Page **0067**

Register of Deeds Stamp & File Number

ACCEPTED BY THE BRANCH COUNTY
SURVEY PEER GROUP AS THE OFFICIAL
CORNER UNDER MICHIGAN PUBLIC ACT 345
OF 1990 AT A MEETING HELD ON
DEC. 07, 1999

E.R. Reed, P.S.
E.R. REED

SECTION

For corners in

<u>BRANCH COUNTY</u>	Located In:	Corner Code #
BETHEL TWP		
1. Public Land Survey	T <u>7</u> S R <u>7</u> W	<u>A-11</u>
	T _____ R _____	_____
	T _____ R _____	_____
	T _____ R _____	_____
2. Property Controlling in Section	S _____ T _____ R _____	_____
	S _____	_____
	T _____ R _____	_____
3. Miscellaneous	S _____	_____
	T _____ R _____	_____
Property in Sec.	S _____	_____
	T _____ R _____	_____

4. Lot No. _____, Recorded Plat _____

5. Private Claims _____

I, EDWARD W. REED, in a field survey on DEC. 6, 1999 do hereby state that under requirements of P.A. 74, Michigan P.A. of 1970, the corner points mentioned in lines 1 and 2 above were in conformance with regulations and rules therefore as required in the current manual of survey instructions of the United States Department of the Interior, Bureau of Land Management or by a decree of a Court of Law and /or that the corner points mentioned in lines 3, 4 and 5 above were in conformance with the rules of the Michigan Board of Land Surveyors or by a Decree of a Court of Law; established, re-established, monumented, recovered, found as expressed below:

NOTE: Not more than 2 corners, all in the same town and range, may be recorded on this certificate.

SOUTHWEST CORNER OF SECTION 30 AND NORTHWEST OF SECTION 31

A. Description of original monument and accessories and/or subsequent restoration:

- 1826: WM. BROOKFIELD, CORNER SET
- 1890: J.H. BENNETT-FOUND OLD STAKE, SET RAIL, 30" TRIANGULAR WITH STONES AROUND
- 1903: CHAS. HAMILTON-FOUND BENNETT'S CORNER

B. Description of corner evidence found and/or method applied in restoring or reestablishing corner:


DUG TO DEPTH OF 3 FEET, STILL IN ROAD GRAVEL FILL AND THE AREA HAS BEEN DUG FOR CULVERT GLO OFFSET OF 40 LINKS (26.4) FITS A STRAIGHT LINE EXTENDED FROM 1/4 CORNER & SECTION CORNER EAST SET POINT AT GLO OFFSET OF 40 LINKS NORTH OF BRONSON CORNER M-11

C. Description of monument for corner and accessories established to perpetuate locating the position of the corner:

- | | |
|---|----------------|
| SET 1/2" X 18" IRON AND REMON CAP IN CAST IRON MONUMENT BOX FLUSH WITH PAVED ROAD SURFACE | |
| BRONSON CORNER | SOUTH 40 LINKS |
| USGS BENCH | S42E 21.43' |
| CENTER OF CONCRETE CATCH BASIN | S68E 37.9' |
| CENTERLINE EAST-WEST ROAD | NORTH 9.4' |
| RR TIE CORNER POST | N33W 46.31' |

AND IS ACCEPTED AS A CAREFUL AND FAITHFUL REESTABLISHMENT OF THE POSITION OF THE ORIGINAL CORNER.

Signed by Edward W. Reed
EDWARD W. REED

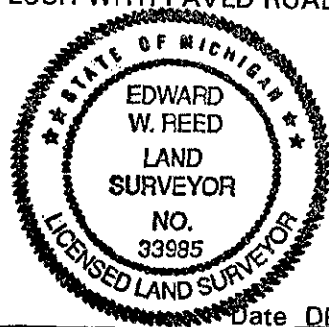

Date DEC. 6, 1999

Surveyor's Michigan License No. 33985

	A	B	C	D	E	F	G	H	I	J	K	L	M
1													
2	6	5	4	3	2	1							
3													
4	7	8	9	10	11	12							
5													
6	18	17	16	15	14	13							
7													
8	19	20	21	22	23	24							
9													
10	30	29	28	27	26	25							
11													
12	31	32	33	34	35	36							
13													