

**SURVEY &  
REMONUMENTATION**

MAR 13 1998

SECTION

**BRANCH COUNTY REMONUMENTATION CORNER  
LAND CORNER RECORDATION CERTIFICATE  
Filing Requirement of Act 74, Mich. P.A. 1970**

STATE OF MICHIGAN  
Branch County  
Recorded

12-30-1997 10:04:52

Linda Lee Morrison-Mathews  
REGISTER OF DEEDS

Liber **00003** Page **0188**

Register of Deeds Stamp & File Number

For corners in

<u>BRANCH</u>	Located In:	Corner Code #
(County)		
BETHEL TWP.		
1. Public Land Survey	T <u>7</u> S <u>R</u> 7 W	<u>E-3</u>
	T <u>   </u> R <u>   </u>	<u>   </u>
	T <u>   </u> R <u>   </u>	<u>   </u>
	T <u>   </u> R <u>   </u>	<u>   </u>
2. Property Controlling in Section	S <u>   </u> T <u>   </u> R <u>   </u>	<u>   </u>
	S <u>   </u> T <u>   </u> R <u>   </u>	<u>   </u>
3. Miscellaneous Property in Sec.	S <u>   </u> T <u>   </u> R <u>   </u>	<u>   </u>
	S <u>   </u> T <u>   </u> R <u>   </u>	<u>   </u>

4. Lot No. \_\_\_\_\_, Recorded Plat \_\_\_\_\_  
5. Private Claims \_\_\_\_\_

I, EDWARD W. REED, in a field survey on NOVEMBER 30, 1997 do hereby state that under requirements of P.A. 74, Michigan P.A. of 1970, the corner points mentioned in lines 1 and 2 above were in conformance with regulations and rules therefore as required in the current manual of survey instructions of the United States Department of the Interior, Bureau of Land Management or by a decree of a Court of Law and /or that the corner points mentioned in lines 3, 4 and 5 above were in conformance with the rules of the Michigan Board of Land Surveyors or by a Decree of a Court of Law; established, re-established, monumented, recovered, found as expressed below:

**NOTE: Not more than 2 corners, all in the same town and range, may be recorded on this certificate.**

A	B	C	D	E	F	G	H	I	J	K	L	M
1												
2	6		5		4		3		2		1	
3				●								
4	7		8		9		10		11		12	
5												
6	18		17		16		15		14		13	
7												
8	19		20		21		22		23		24	
9												
10	30		29		28		27		26		25	
11												
12	31		32		33		34		35		36	
13												

ACCEPTED BY THE BRANCH COUNTY  
SURVEY PEER GROUP AS THE OFFICIAL  
CORNER UNDER MICHIGAN PUBLIC ACT 345  
OF 1990 AT A MEETING HELD ON  
12-08-97

E. R. Reed

**E.R. REED**

A. Description of original monument and accessories and/or subsequent restoration:  
SECTION CORNER COMMON TO SECTIONS 4-5-8-9

1826: W. BROOKFIELD, D.S. - CORNER SET  
1869: J.H. BENNETT: SURVEYOR - STONE WITH COBBLES PLANTED


B. Description of corner evidence found and/or method applied in restoring or reestablishing corner:

DUG LARGE HOLE IN LINE WITH FENCE RUNNING WEST, FOUND POINTED STONE  
ON LINE WITH QUARTER CORNER AND SECTION CORNER TO NORTH

C. Description of monument for corner and accessories established to perpetuate locating the position of the corner:

SET 1/2" X 18" REBAR IRON WITH REMON CAP IN CI-MONUMENT BOX 4" BELOW GRAVEL ROAD GRADE

IN LINE WITH FENCE RUNNING WEST  
WOOD ANCHOR POST, DUE WEST 19.40' TO FACE  
SW CORNER BARN, S30E 100.60'  
TEL. PED, N08W 130.62' TO FACE  
CENTER OF 8" OAK, N80E 56.5'  
SE CORNER HOUSE, N42E 155.61'

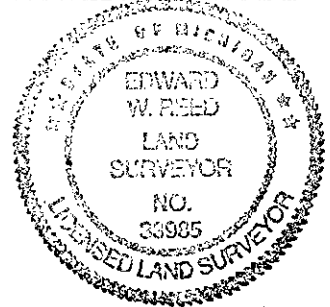

AND IS ACCEPTED AS A CAREFUL AND FAITHFUL PERPETUATION OF THE POSITION OF THE ORIGINAL CORNER

Signed by Edward W. Reed  
EDWARD W. REED

Date NOVEMBER 31, 1997

Surveyor's Michigan License No. 33985