

**BRANCH COUNTY REMONUMENTATION PROGRAM  
LAND CORNER RECORDATION CERTIFICATE  
Filing Requirement of Act 74, Mich. P.A. 1970**

STATE OF MICHIGAN  
Branch County  
Recorded

12-30-1999 11:03:30

Linda Lee Morrison-Mathews  
REGISTER OF DEEDS

Liber **00004** Page **0068**

**Register of Deeds Stamp & File Number**

ACCEPTED BY THE BRANCH COUNTY  
SURVEY PEER GROUP AS THE OFFICIAL  
CORNER UNDER MICHIGAN PUBLIC ACT 345  
OF 1990 AT A MEETING HELD ON  
DEC. 07, 1999

E.R. Reed, P.S.  
E.R. REED

	A	B	C	D	E	F	G	H	I	J	K	L	M
1			●										
2	6		5		4		3		2		1		
3													
4	7		8		9		10		11		12		
5													
6	18		17		16		15		14		13		
7													
8	19		20		21		22		23		24		
9													
10	30		29		28		27		26		25		
11													
12	31		32		33		34		35		36		
13													

For corners in

<u>BRANCH COUNTY</u> BRONSON TWP	Located In:	Corner Code #
1. Public Land Survey	<u>T 7 S R 8 W</u>	<u>C-01</u>
	T <u>    </u> R <u>    </u>	<u>    </u>
	T <u>    </u> R <u>    </u>	<u>    </u>
	T <u>    </u> R <u>    </u>	<u>    </u>
2. Property Controlling in Section	S <u>    </u> T <u>    </u> R <u>    </u>	<u>    </u>
	S <u>    </u>	<u>    </u>
	T <u>    </u> R <u>    </u>	<u>    </u>
3. Miscellaneous	S <u>    </u>	<u>    </u>
	T <u>    </u> R <u>    </u>	<u>    </u>
Property in Sec.	S <u>    </u>	<u>    </u>
	T <u>    </u> R <u>    </u>	<u>    </u>

4. Lot No. \_\_\_\_\_, Recorded Plat \_\_\_\_\_

5. Private Claims \_\_\_\_\_

I, EDWARD W. REED, in a field survey on JUNE 1, 19 99 do hereby state that under requirements of P.A. 74, Michigan P.A. of 1970, the corner points mentioned in lines 1 and 2 above were in conformance with regulations and rules therefore as required in the current manual of survey instructions of the United States Department of the Interior, Bureau of Land Management or by a decree of a Court of Law and /or that the corner points mentioned in lines 3, 4 and 5 above were in conformance with the rules of the Michigan Board of Land Surveyors or by a Decree of a Court of Law; established, re-established, monumented, recovered, found as expressed below:

**NOTE: Not more than 2 corners, all in the same town and range, may be recorded on this certificate.**

**NORTHEAST CORNER SECTION 6 & NORTHWEST CORNER SECTION 5**

A. Description of original monument and accessories and/or subsequent restoration:

1826: Wm BROOKFIELD, D.S. - CORNER SET  
1856: H. CARY, SURVEYOR - SURVEY  
1916: T. SHAVER, SURVEYOR - STONE & WITNESS, 18" MAPLE, S66E 0.890 CH.

B. Description of corner evidence found and/or method applied in restoring or reestablishing corner:


FOUND POINTED STONE, BRICK, AND OLD IRON FITTING ONE REMAINING WITNESS OF SHAVER.  
FOUND NEW FLAGGING AROUND STONE AND NEW P.K. NAIL WITH FLAGGING IN TREE.

C. Description of monument for corner and accessories established to perpetuate locating the position of the corner:

REMOVED STONE AND SET 3/4" x 12" REBAR UNDER 1/2" x 18" REBAR AND REMON. CAP IN CI - MON BOX 4" BELOW GRADE

OLD WITNESS 18" MAPLE ( NOW 50" )	S66E	0.89 CHAINS (58.74')
NEW WITNESS PK NAIL, N SIDE, 50" MAPLE	S66E	57.77'
E. FACE OF 12" CONCRETE ANCHOR POST	WEST	28.00'
CENTER OF 12" WALNUT	S85W	22.67'
CENTER OF 8" WALNUT	S10E	22.55'

AND IS ACCEPTED AS A CAREFUL AND FAITHFUL PERPETUATION OF THE POSITION OF THE ORIGINAL CORNER.

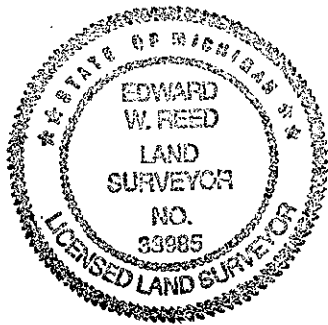

Signed by Edward W. Reed  
EDWARD W. REED

Date JUNE 1, 1999

Surveyor's Michigan License No. 33985