SECTION

BRANCH COUNTY REMONUMENTATION PROGRAM
LAND CORNER RECORDATION CERTIFICATE
Filing Requirement of Act 74, Mich. P.A. 1970

STATE OF MICHIGAN
Branch County
Recorded

12-30-1999 11:03:52

Linda Lee Morrison-Matheus
REGISTER OF DEEDS

Liber 00004 Page 0071

Register of Deeds Stamp & File Number

ACCEPTED BY THE BRANCH COUNTY SURVEY PEER GROUP AS THE OFFICIAL CORNER UNDER MICHIGAN PUBLIC ACT 345 OF 1990 AT A MEETING HELD ON DEC. 07, 1999.
E.R. Reed, P.S.
E.R. REED

For corners in

BRANCH COUNTY
BRONSON TWP

	Located In:	Corner Code #
1. Public Land Survey	T 7 S R 8 W	C-5
	T___ R___	
	T___ R___	
	T___ R___	
2. Property Controlling in Section	S___ T___ R___	
	S___ T___ R___	
3. Miscellaneous Property in Sec.	S___ T___ R___	
	S___ T___ R___	

4. Lot No. _____, Recorded Plat _____

5. Private Claims _____

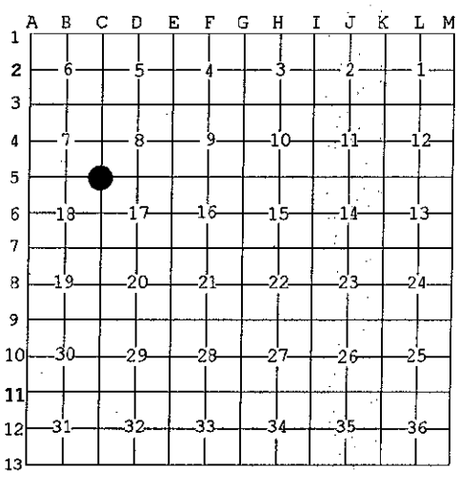

I, EDWARD W. REED, in a field survey on OCT 21, 19 99 do hereby state that under requirements of P.A. 74, Michigan P.A. of 1970, the corner points mentioned in lines 1 and 2 above were in conformance with regulations and rules therefore as required in the current manual of survey instructions of the United States Department of the Interior, Bureau of Land Management or by a decree of a Court of Law and /or that the corner points mentioned in lines 3, 4 and 5 above were in conformance with the rules of the Michigan Board of Land Surveyors or by a Decree of a Court of Law; established, re-established, monumented, recovered, found as expressed below:

NOTE: Not more than 2 corners, all in the same town and range, may be recorded on this certificate.

CORNER COMMON TO SECTIONS 7, 8, 17, & 18

A. Description of original monument and accessories and/or subsequent restoration:
1826: WM. BROOKFIELD-CORNER SET
1892: I.D. MINER-SET GRANITE BOLDER

B. Description of corner evidence found and/or method applied in restoring or reestablishing corner:
DUG LARGE HOLE WITH BACKHOE 5' DEEP DOWN TO OLD CORDUROY ROAD
FOUND NO EVIDENCE OF CORNER
USING 1/4 SECTION CORNERS NORTH & SOUTH - AS ONLY EVIDENCE AVAILABLE - RESET CORNER
SET 1/2" X 18" IRON OVER 3/4" X 30" IRON WITH REMON CAP IN CAST IRON BOX 5" BELOW GRAVEL

C. Description of monument for corner and accessories established to perpetuate locating the position of the corner:
½" X 18" IRON OVER 3/4" X 30" IRON WITH REMON CAP IN CAST IRON BOX 5" BELOW GRAVEL

TAG ON EAST SIDE OF POWER POLE	N9W 131.11'
TAG ON WEST SIDE OF POWER POLE	N27E 52.73'
TAG ON NORTH SIDE 12" TRIPLE LOCUST	S 28E 60.5'
TAG ON NORTH SIDE 10" MULTI LOCUST	S58W 59.6'
NORTH CONCRETE HEAD WALL OF OLD BRIDGE	SOUTH 197.30'

STATE OF MICHIGAN
EDWARD W. REED
LAND SURVEYOR
NO. 33985
LICENSED LAND SURVEYOR

AND IS ACCEPTED AS A CAREFUL AND FAITHFUL REESTABLISHMENT OF THE POSITION OF THE ORIGINAL CORNER.

Signed by Edward W. Reed Date OCT. 21, 1999

EDWARD W. REED

Surveyor's Michigan License No. 33985

FORM APPROVED BY MICHIGAN STATE BOARD OF PROFESSIONAL SURVEYORS, JAN. 28, 1971
REVISED MAY 14,1975
REVISED JAN., 1983
REVISED OCT., 1995