

SURVEY & REMONUMENTATION

MAR 21 1997

BRANCH COUNTY REMONUMENTATION CORNER Liber 00003 Page 0061
 LAND CORNER RECORDATION CERTIFICATE

Filing Requirement of Act 74, Mich. P.A. 1970

For corners in **COMMISSION**

STATE OF MICHIGAN
 Branch County
 Recorded

10-30-1996 09:13:38

Linda Lee Morrison-Mathews
 REGISTER OF DEEDS

Register of Deeds Stamp & File Number

<u>BRANCH</u> (County)	Located In:	Corner Code #
BRONSON TWP.	T 7 S R 8 W	G-6
1. Public Land Survey	T _____ R _____	_____
	T _____ R _____	_____
	T _____ R _____	_____
	T _____ R _____	_____
2. Property Controlling in Section	S _____ T _____ R _____	_____
	S _____ T _____ R _____	_____
3. Miscellaneous Property in Sec.	S _____ T _____ R _____	_____
	S _____ T _____ R _____	_____
4. Lot No. _____, Recorded Plat _____		
5. Private Claims _____		

	A	B	C	D	E	F	G	H	I	J	K	L	M
2	6		5		4		3		2		1		
3													
4	7		8		9		10		11		12		
5													
6	18		17		16		15		14		13		
7													
8	19		20		21		22		23		24		
9													
10	30		29		28		27		26		25		
11													
12	31		32		33		34		35		36		
13													

I, EDWARD W. REED, in a field survey on SEPTEMBER 4, 19 96, do hereby certify that under requirements of P.A. 74, Michigan P.A. of 1970, the corner points mentioned in lines 1 and 2 above were in conformance with regulations and rules therefore as required in the current manual of survey instructions of the United States Department of the Interior, Bureau of Land Management or by a decree of a Court of Law and/or that the corner points mentioned in lines 3, 4 and 5 above were in conformance with the rules of the Michigan Board of Land Surveyors or by a Decree of a Court of Law; established, re-established, monumented, re-monumented, recovered, found as expressed below:

NOTE: Not more than 4 corners, all in the same town and range, may be recorded on this certificate.


A. Description of original monument and accessories and/or subsequent restoration:
 QUARTER CORNER COMMON TO SECTIONS 15 & 16, T7S, R8W, BRONSON TWP, BRANCH COUNTY, MI
 1826: W. BROOKFIELD, DEP. SURVEYOR, CORNER SET
 1879: KNOWLES, FOUND STAKE HOLE, SET BRICKIN HOLE & 18" STONE
 1945: HAROLD RUSSELL, COUNTY SURVEYOR, IRON PIPE SET AT CORNER
 1953: E.R. REED, COUNTY SURVEYOR, FOUND IRON & STONE
 1991: DONALD ANDREWS, SURVEYOR, FOUND IRON & CROCKERY, RECORDED L.C.R.C. #II-213

B. Description of corner evidence found and/or method applied in restoring or reestablishing corner:
 FOUND 3/4" IRON ROD
 PLACED 1/2" x 18" IRON OVER TOP OF OLD IRON WITH REMONUMENTATION CAP ON IRON
 SET CAST IRON BOX 2" BELOW GRAVEL ROAD SURFACE

ACCEPTED BY THE BRANCH COUNTY SURVEY PEER GROUP AS THE OFFICIAL CORNER UNDER MICHIGAN PUBLIC ACT 345 OF 1990 AT A MEETING HELD ON OCT. 9, 1996

E.R. Reed, Co. Rep.
 E.R. REED

C. Description of monument for corner and accessories established to perpetuate locating the position of the corner:
 1/2" x 18" IRON WITH REMONUMENTATION CAP IN CAST IRON BOX
 N21E 78.29' TO FACE OF RR TIE POST
 N77E 36.00' TO CENTER OF 30" MAPLE
 S50E 35.86' TO 12" MAPLE
 N84W 33.0' TO FACE OF RR TIE POST
 S56W 88.5' TO SE CORNER OF HOUSE
 S15W 118.6' TO FACE OF POWER POLE
 N7W 140.1' TO FACE OF POWER POLE

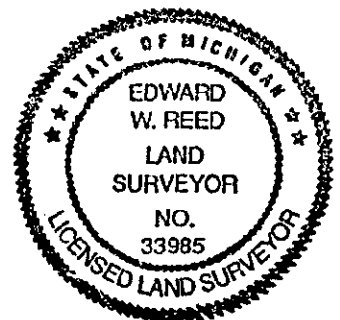

AND IS ACCEPTED AS A CAREFUL AND FAITHFUL PERPETUATION OF THE POSITION OF THE ORIGINAL CORNER.

Signed by Edward W. Reed Date SEPTEMBER 4, 1996
 Surveyor's Michigan License No. 33985