

**SURVEY & REMONUMENTATION**

FEB 08 1999

**SECTION**

**BRANCH COUNTY REMONUMENTATION PROGRAM  
LAND CORNER RECORDATION CERTIFICATE  
Filing Requirement of Act 74, Mich. P.A. 1970**

For corners in

<u>BRANCH COUNTY</u> <u>BRONSON TWP</u>	Located In:	Corner Code #
1. Public Land Survey	<u>T 7 S R 8 W</u>	<u>L-11</u>
	T _____ R _____	_____
	T _____ R _____	_____
	T _____ R _____	_____
2. Property Controlling in Section	S _____ T _____ R _____	_____
	S _____	_____
	T _____ R _____	_____
3. Miscellaneous	S _____	_____
	T _____ R _____	_____
Property in Sec.	S _____	_____
	T _____ R _____	_____

STATE OF MICHIGAN  
Branch County  
Recorded

11-04-1998 15:49:38

Linda Lee Morrison-Mathews  
REGISTER OF DEEDS

Register of Deeds Stamp & File Number

ACCEPTED BY THE BRANCH COUNTY  
SURVEY PEER GROUP AS THE OFFICIAL  
CORNER UNDER MICHIGAN PUBLIC ACT 345  
OF 1980 AT A MEETING HELD ON  
9-9-1998

*E.R. Reed, Co. R.P.*

**E.R. REED**

4. Lot No. \_\_\_\_\_, Recorded Plat \_\_\_\_\_  
5. Private Claims \_\_\_\_\_

I, EDWARD W. REED, in a field survey on July 18, 1998 do hereby state that under requirements of P.A. 74, Michigan P.A. of 1970, the corner points mentioned in lines 1 and 2 above were in conformance with regulations and rules therefore as required in the current manual of survey instructions of the United States Department of the Interior, Bureau of Land Management or by a decree of a Court of Law and /or that the corner points mentioned in lines 3, 4 and 5 above were in conformance with the rules of the Michigan Board of Land Surveyors or by a Decree of a Court of Law; established, re-established, monumented, recovered, found as expressed below:

NOTE: Not more than 2 corners, all in the same town and range, may be recorded on this certificate.

Quarter corner common to sections 25 & 36

A. Description of original monument and accessories and/or subsequent restoration:

- 1826: WM. BROOKFIELD, DEPT. SURVEYOR - CORNER SET
- 1881: C. HAMILTON, CO. SURVEYOR - FOUND STONE & STAKE
- 1892: I.D. MINER, CO SURVEYOR - FOUND STONE
- 1916: D.W. DUDLEY, DEPT. CO. SURVEYOR - FOUND LONG STONE, SET ON END

B. Description of corner evidence found and/or method applied in restoring or reestablishing corner:

FOUND CAPPED IRON 1/2" X 30" (# 33967-13165) AGREEING WITH WITNESS OF DW DUDLEY, NO STONE FOUND

C. Description of monument for corner and accessories established to perpetuate locating the position of the corner:


SET 1/2" X 18" REBAR IRON WITH REMON CAP IN CI-MONUMENT BOX SET FLUSH WITH ROAD SURFACE

- P. POLE S 32 E 47.1' TO FACE
- TEL PED. S 43 W 43.2'
- TEL PED N 19 E 89.4' TO FACE
- 36" MAPLE N 22 E 96.4' TO CENTER
- 5" ROUND STEEL CORNER POST N 39 W 34.3' TO FACE
- IN CENTERLINE OF N-S-E-W ROADS

AND IS ACCEPTED AS A CAREFUL AND FAITHFUL PERPETUATION OF THE POSITION OF THE ORIGINAL CORNER.

Signed by *Edward W. Reed*  
EDWARD W, REED

Surveyor's Michigan License No. 33985

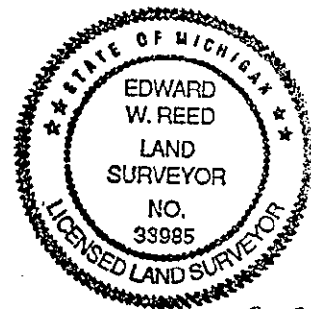

Date 9-9-98

Liber 00003 Page 0232