

SURVEY & REMONUMENTATION

FEB 08 1999

SECTION

BRANCH COUNTY REMONUMENTATION PROGRAM
LAND CORNER RECORDATION CERTIFICATE
Filing Requirement of Act 74, Mich. P.A. 1970

Liber 00003 Page 0265

For corners in

<u>BRANCH COUNTY</u> BRONSON TWP	Located In:	Corner Code #
1. Public Land Survey	T <u>7</u> S R <u>8</u> W	<u>M-11</u>
	T _____ R _____	_____
	T _____ R _____	_____
	T _____ R _____	_____
2. Property Controlling in Section	S _____ T _____ R _____	_____
	S _____	_____
	T _____ R _____	_____
3. Miscellaneous	S _____	_____
	T _____ R _____	_____
Property in Sec.	S _____	_____
	T _____ R _____	_____

STATE OF MICHIGAN
Branch County
Recorded

12-07-1998 13:56:17

Linda Lee Morrison-Mathews
REGISTER OF DEEDS

Register of Deeds Stamp & File Number

ACCEPTED BY THE BRANCH COUNTY
SURVEY PEER GROUP AS THE OFFICIAL
CORNER UNDER MICHIGAN PUBLIC ACT 345
OF 1990 AT A MEETING HELD ON

11-04-1998

E.R. Reed C. Rep.
E.R. REED

4. Lot No. _____, Recorded Plat _____

5. Private Claims _____

I, EDWARD W. REED, in a field survey on OCTOBER 30, 19 98 do hereby state that under requirements of P.A. 74, Michigan P.A. of 1970, the corner points mentioned in lines 1 and 2 above were in conformance with regulations and rules therefore as required in the current manual of survey instructions of the United States Department of the Interior, Bureau of Land Management or by a decree of a Court of Law and /or that the corner points mentioned in lines 3, 4 and 5 above were in conformance with the rules of the Michigan Board of Land Surveyors or by a Decree of a Court of Law; established, re-established, monumented, recovered, found as expressed below:

NOTE: Not more than 2 corners, all in the same town and range, may be recorded on this certificate.

SOUTHEAST CORNER SECTION 25
NORTHEAST CORNER SECTION 36

	A	B	C	D	E	F	G	H	I	J	K	L	M
1													
2	6		5		4		3		2		1		
3													
4	7		8		9		10		11		12		
5													
6	18		17		16		15		14		13		
7													
8	19		20		21		22		23		24		
9													
10	30		29		28		27		26		25		
11													
12	31		32		33		34		35		36		
13													

A. Description of original monument and accessories and/or subsequent restoration:

1825: JOHN MULLETT, DEPT. SURVEYOR - CORNER SET
OLD NOTES INDICATE - WELL POINT & STONE


B. Description of corner evidence found and/or method applied in restoring or reestablishing corner:

FOUND EVIDENCE OF OLD WELL POINT NEAR POINTED STONE, AT BASE OF COTTONWOOD TREE

C. Description of monument for corner and accessories established to perpetuate locating the position of the corner:

SET 3/4" X 30" REBAR IRON ALONG NORTH SIDE OF STONE; ALSO SET 1/2" X 18" REBAR IRON WITH REMON CAP ALONG SIDE

AT NORTH EDGE OF 30" COTTONWOOD
USGS ELEVATION BENCHMARK N 55 E 20.78'
CENTER OF CONCRETE CATCH BASIN N 71 E 39.2'
C/L EAST-WEST PAVED ROAD NORTH 35.6'
IN LINE WITH OLD REMAINS OF FENCE NORTH
SET CARSONITE MARKER ON NORTH EDGE OF POINT

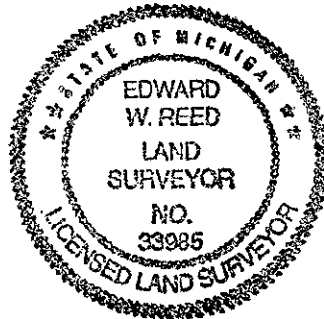

AND IS ACCEPTED AS THE BEST AVAILABLE EVIDENCE OF THE POSITION OF THE ORIGINAL CORNER.

Signed by *Edward W. Reed*

EDWARD W, REED

Date Nov. 4, 1998

Surveyor's Michigan License No. 33985