

SURVEY & REMONUMENTATION

FEB 08 1999

SECTION

**BRANCH COUNTY REMONUMENTATION PROGRAM
LAND CORNER RECORDATION CERTIFICATE
Filing Requirement of Act 74, Mich. P.A. 1970**

Liber **000003** Page **0266**

For corners in

<u>BRANCH COUNTY</u> CALIFORNIA TWP	Located In:	Corner Code #
1. Public Land Survey	<u>T 8 S R 5 W</u>	<u>C-3</u>
	T _____ R _____	_____
	T _____ R _____	_____
	T _____ R _____	_____
2. Property Controlling in Section	S _____ T _____ R _____	_____
	S _____	_____
	T _____ R _____	_____
3. Miscellaneous	S _____	_____
	T _____ R _____	_____
Property in Sec.	S _____	_____
	T _____ R _____	_____

STATE OF MICHIGAN
Branch County
Recorded

12-07-1998 13:56:26

Linda Lee Morrison-Mathews
REGISTER OF DEEDS

Register of Deeds Stamp & File Number

ACCEPTED BY THE BRANCH COUNTY
SURVEY PEER GROUP AS THE OFFICIAL
CORNER UNDER MICHIGAN PUBLIC ACT 346
OF 1990 AT A MEETING HELD ON

11-04-1998

E.K. Reed Co. Rep.
E.R. REED

4. Lot No. _____, Recorded Plat _____
5. Private Claims _____

I, EDWARD W. REED, in a field survey on SEPT. 16, 19 98 do hereby state that under requirements of P.A. 74, Michigan P.A. of 1970, the corner points mentioned in lines 1 and 2 above were in conformance with regulations and rules therefore as required in the current manual of survey instructions of the United States Department of the Interior, Bureau of Land Management or by a decree of a Court of Law and /or that the corner points mentioned in lines 3, 4 and 5 above were in conformance with the rules of the Michigan Board of Land Surveyors or by a Decree of a Court of Law; established, re-established, monumented, recovered, found as expressed below:

NOTE: Not more than 2 corners, all in the same town and range, may be recorded on this certificate.

CORNER COMMON TO SECTIONS 5-6-7-8

A. Description of original monument and accessories and/or subsequent restoration:

- 1828: ROBERT CLARK JR., DEPT. SURVEYOR- CORNER SET
- 1927: E.L. MINER, CO. SURVEYOR- FOUND STAKE, SET 1/2"x 2" IRON STAKE
IN HEAVY DEPOSIT OF COBBLES AND BRICKBAT'S IN LINE OF FENCES RUNNING N-S
- 1987: E.R. REED, CO. SURVEYOR, IRON ROD

B. Description of corner evidence found and/or method applied in restoring or reestablishing corner:


FOUND 1/2"x18" IRON ROD OVER 1/2" IRON ROD 24" BELOW ROAD SURFACE, ROAD REMAINS OF BRICKS.

C. Description of monument for corner and accessories established to perpetuate locating the position of the corner:

SET 1/2"x18" REBAR IRON AND REMON CAP IN CI-MONUMENT BOX FLUSH WITH PAVED ROAD SURFACE.

WOOD CORNER POST	NORTH	34.8 TO FACE
TEL PED	N-82-E	152.75 TO FULL 26"
24" OAK	N-28-E	31.6 TO CENTER 28"
28" MAPLE	N-85-E	170.5 TO CENTER

IN LINE WITH FENCE RUNNING NORTH

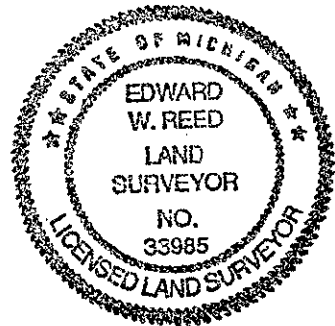

AND IS ACCEPTED AS A CAREFUL AND FAITHFUL PERPETUATION OF THE POSITION OF THE ORIGINAL CORNER.

Signed by *Edward W. Reed*
EDWARD W. REED

Date NOV 4, 1998

Surveyor's Michigan License No. 33985

	A	B	C	D	E	F	G	H	I	J	K	L	M
1													
2		6	5		4		3		2		1		
3			●										
4		7		8		9		10		11		12	
5													
6		18		17		16		15		14		13	
7													
8		19		20		21		22		23		24	
9													
10		30		29		28		27		26		25	
11													
12		31		32		33		34		35		36	