

SURVEY & REMONUMENTATION

MAR 13 1998

SECTION

BRANCH COUNTY REMONUMENTATION CORNER  
LAND CORNER RECORDATION CERTIFICATE  
Filing Requirement of Act 74, Mich. P.A. 1970

STATE OF MICHIGAN  
Branch County  
Recorded

For corners in

BRANCH (County)	Located In:	Corner Code #
CALIFORNIA TWP.	T <u>8S</u> R <u>5W</u>	<u>G-3</u>
1. Public Land Survey	T ___ R ___	_____
	T ___ R ___	_____
	T ___ R ___	_____
2. Property Controlling in Section	S ___ T ___ R ___	_____
	S ___ T ___ R ___	_____
3. Miscellaneous Property in Sec.	S ___ T ___ R ___	_____
	S ___ T ___ R ___	_____

10-22-1997 09:54:33

Linda Lee Morrison-Mathews  
REGISTER OF DEEDS

Liber 00003 Page 0147

Register of Deeds Stamp & File Number

4. Lot No. \_\_\_\_\_, Recorded Plat \_\_\_\_\_  
5. Private Claims \_\_\_\_\_

I, EDWARD W. REED, in a field survey on APRIL 26, 1997 do hereby state that under requirements of P.A. 74, Michigan P.A. of 1970, the corner points mentioned in lines 1 and 2 above were in conformance with regulations and rules therefore as required in the current manual of survey instructions of the United States Department of the Interior, Bureau of Land Management or by a decree of a Court of Law and /or that the corner points mentioned in lines 3, 4 and 5 above were in conformance with the rules of the Michigan Board of Land Surveyors or by a Decree of a Court of Law, established, re-established, monumented, recovered, found as expressed below:

NOTE: Not more than 2 corners, all in the same town and range, may be recorded on this certificate.

	A	B	C	D	E	F	G	H	I	J	K	L	M
1													
2		6		5		4		3		2		1	
3							●						
4		7		8		9		10		11		12	
5													
6		18		17		16		15		14		13	
7													
8		19		20		21		22		23		24	
9													
10		30		29		28		27		26		25	
11													
12		31		32		33		34		35		36	
13													

A. Description of original monument and accessories and/or subsequent restoration:  
CORNER COMMON TO SECTIONS 3, 4, 9 & 10, CALIFORNIA TWP.

1828: ROBERT CLARK, JR., DEPUTY SURVEYOR, CORNER SET  
1905: CHARLES HAMILTON, COUNTY SURVEYOR, FOUND WAGON SKEIN IN CENTER OF STREET  
1971: E.R. REED, COUNTY SURVEYOR, FOUND IRON ROD ON END 10" BELOW ROAD SURFACE (IRON ROD IS "WAGON SKEIN MENTIONED ABOVE), RECORDED IN L.C.R.C. #0023

B. Description of corner evidence found and/or method applied in restoring or reestablishing corner:

FOUND MONUMENTATION BOX AND IRON WAGON SKEIN  
SET 1/2" IRON WITH REMONUMENTATION CAP

C. Description of monument for corner and accessories established to perpetuate locating the position of the corner:  
1/2" IRON WITH REMONUMENTATION CAP IN CAST IRON BOX  
N84E 107.5' TO SW CORNER OF GARAGE  
S39E 42.5' TO NAIL & WASHER IN N SIDE OF POWER POLE  
S74W 80.2' TO NE CORNER OF TELEPHONE PEDESTAL


AND IS ACCEPTED AS A CAREFUL AND FAITHFUL PERPETUATION OF THE POSITION OF THE ORIGINAL CORNER

Signed by Edward W. Reed

Date APRIL 26, 1997

EDWARD W. REED

Surveyor's Michigan License No. 33985

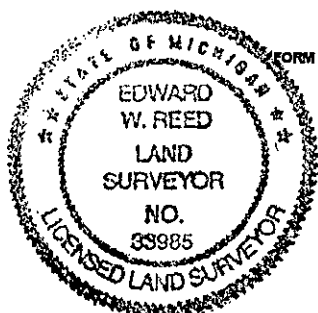

FORM APPROVED BY MICHIGAN STATE BOARD OF PROFESSIONAL SURVEYORS, JAN. 28, 1971  
REVISED MAY 14, 1975

ACCEPTED BY THE BRANCH COUNTY  
SURVEY PEER GROUP AS THE OFFICIAL  
CORNER UNDER MICHIGAN PUBLIC ACT 345  
OF 1990 AT A MEETING HELD ON

REVISED JAN., 198  
REVISED OCT., 198

9-10-97  
E.R. Reed P.S. Co. Rep.  
E.R. REED