

**SURVEY & REMONUMENTATION**

MAR 13 1998

**SECTION**

**BRANCH COUNTY REMONUMENTATION CORNER  
LAND CORNER RECORDATION CERTIFICATE  
Filing Requirement of Act 74, Mich. P.A. 1970**

STATE OF MICHIGAN  
Branch County  
Recorded

For corners in

BRANCH	Located In:	Corner Code #
(County)		
CALIFORNIA TWP.	T 8 S R 5 W	I-3
1. Public Land Survey	T _____ R _____	_____
	T _____ R _____	_____
	T _____ R _____	_____
2. Property Controlling in Section	S _____ T _____ R _____	_____
	S _____ T _____ R _____	_____
3. Miscellaneous Property in Sec.	S _____ T _____ R _____	_____
	S _____ T _____ R _____	_____

10-22-1997 09:54:40

Linda Lee Morrison-Matheus  
REGISTER OF DEEDS

Liber 00003 Page 0148

Register of Deeds Stamp & File Number

4. Lot No. \_\_\_\_\_, Recorded Plat \_\_\_\_\_  
5. Private Claims \_\_\_\_\_

I, EDWARD W. REED, in a field survey on APRIL 16, 1997 do hereby state that under requirements of P.A. 74, Michigan P.A. of 1970, the corner points mentioned in lines 1 and 2 above were in conformance with regulations and rules therefore as required in the current manual of survey instructions of the United States Department of the Interior, Bureau of Land Management or by a decree of a Court of Law and for that the corner points mentioned in lines 3, 4 and 5 above were in conformance with the rules of the Michigan Board of Land Surveyors or by a Decree of a Court of Law; established, re-established, monumented, recovered, found as expressed below:

**NOTE: Not more than 2 corners, all in the same town and range, may be recorded on this certificate.**

A	B	C	D	E	F	G	H	I	J	K	L	M
1												
2	6		5		4		3		2		1	
3								●				
4	7		8		9		10		11		12	
5												
6	18		17		16		15		14		13	
7												
8	19		20		21		22		23		24	
9												
10	30		29		28		27		26		25	
11												
12	31		32		33		34		35		36	
13												

A. Description of original monument and accessories and/or subsequent restoration:  
CORNER COMMON TO SECTIONS 2, 3, 10, 11, CALIFORNIA TWP., BRANCH COUNTY, MI.

- 1826: ROBERT CLARK, jr. DEPT. SURVEYOR - CORNER SET
- 1898: I.D. MINER, CO. SURVEYOR - SET SLEIGH SHOE IN BROKEN STONES & BRICK
- 1971: E.R. REED, CO. SURVEYOR - FOUND ROTTEN WOOD STAKE, STONES IN CIRCLE SURROUNDED BY BROKEN BRICK 30" BELOW ROAD SURFACE - SET 3/4" X 24" PIPE AND MONUMENT BOX, RECORDED IN LCRC # 0023

B. Description of corner evidence found and/or method applied in restoring or reestablishing corner:

FOUND MONUMENT BOX AND 3/4" PIPE  
SET 1/2" REBAR INSIDE OF 3/4" PIPE WITH REMONUMENTATION CAP

C. Description of monument for corner and accessories established to perpetuate locating the position of the corner:  
1/2" X 18" REBAR WITH REMONUMENTATION CAP IN CAST IRON BOX  
N52E 57.5' TO CENTER OF 34" FIR TREE  
N72W 153.4' TO CENTER OF 36" ACORN TREE  
N58E 87.0' TO SW CORNER OF HOUSE (NOT PORCH)  
S30E 51.2' TO N FACE OF POWER POLE

AND IS ACCEPTED AS A CAREFUL AND FAITHFUL PERPETUATION OF THE POSITION OF THE ORIGINAL CORNER


Signed by Edward W. Reed  
EDWARD W. REED

Date APRIL 26, 1997

Surveyor's Michigan License No. 33985

ACCEPTED BY THE BRANCH COUNTY SURVEY PEER GROUP AS THE OFFICIAL CORNER UNDER MICHIGAN PUBLIC ACT 345 OF 1990 AT A MEETING HELD ON

9-10-97  
E.R. Reed, P.S. Co. Rep.  
E.R. REED

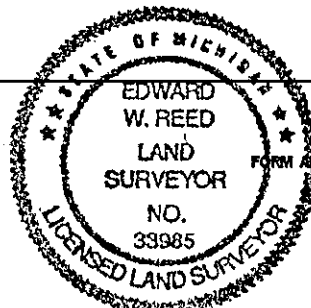

FORM APPROVED BY MICHIGAN STATE BOARD OF PROFESSIONAL SURVEYORS, JAN. 28  
REVISED MAY 14, 1975

REVISED JAN., 198  
REVISED OCT., 199