

**SURVEY &
REMONUMENTATION**

JAN 23 1996

COMMISSION

**BRANCH COUNTY REMONUMENTATION CORNER
LAND CORNER RECORDATION CERTIFICATE
Filing Requirement of Act 74, Mich. P.A. 1970**

For corners in

BRANCH _____

(County)
KINDERHOOK TWP.

1. Public Land Survey

2. Property Controlling
in Section

3. Miscellaneous
Property in Sec.

4. Lot No. _____, Recorded Plat _____

5. Private Claims _____

Located In:

Corner Code ##

T 8S R 6W

E-3

T _____ R _____

T _____ R _____

T _____ R _____

S _____ T _____ R _____

S _____ T _____ R _____

S _____ T _____ R _____


S _____ T _____ R _____

STATE OF MICHIGAN
Branch County
Recorded

09-28-1995 10:21:14

Linda Lee Morrison-Mathews
REGISTER OF DEEDS

Liber **00003** Page **0031**
Register of Deeds Stamp & File Number

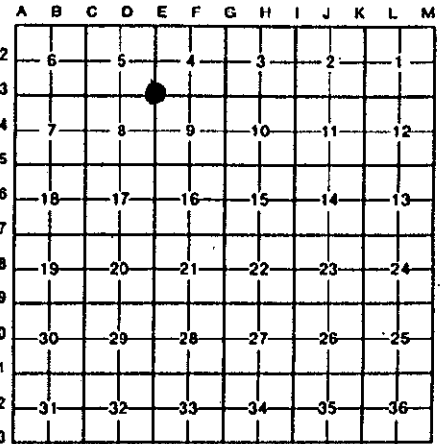

I, Edward W. Reed, in a field survey on June 16, 19 95, do hereby certify that under requirements of P.A. 74, Michigan P.A. of 1970, the corner points mentioned in lines 1 and 2 above were in conformance with regulations and rules therefore as required in the current manual of survey instructions of the United States Department of the Interior, Bureau of Land Management or by a decree of a Court of Law and/or that the corner points mentioned in lines 3, 4 and 5 above were in conformance with the rules of the Michigan Board of Land Surveyors or by a Decree of a Court of Law; established, re-established, monumented, re-monumented, recovered, found as expressed below:

NOTE: Not more than 4 corners, all in the same town and range, may be recorded on this certificate.

A. Description of original monument and accessories and/or subsequent restoration:

CORNER COMMON TO SECTIONS 4, 5, 8, & 9, KINDERHOOK TWP., BRANCH COUNTY, MI.

1828: Robert Clark, Jr., Deputy Surveyor, -set corner
Old section corner card file "stake & coal"

1963: G. B. Wood-found pin

1974: E. R. Reed, County Surveyor, -found broken glass, coal, & old wood stake, placed
3/4" iron

1974: E. R. Reed-recorded corner L.C.R. #112

1988: Jim Boynton-recored corner L.C.R. #128, found pipe

B. Description of corner evidence found and/or method applied in restoring or reestablishing corner:

Found 3/4" iron rod, with 1 1/2" x 23" pipe set on top
Set 1/2" x 18" rebar with remonumentation cap
Set cast iron monument box flush with road surface


ACCEPTED BY THE BRANCH COUNTY
SURVEY PEER GROUP AS THE OFFICIAL
CORNER UNDER MICHIGAN PUBLIC ACT 345
OF 1990 AT A MEETING HELD ON
9-13-95

E. R. Reed, Co. Rep.

C. Description of monument for corner and accessories established to perpetuate locating the position of the corner:

N75°W 136.3'-to face of power pole
N86°E 214.9'-to face of power pole
S34°W 36.2'-14" split oak to P.K. nail
S40°E 44.3'-to center of 24" stump
E-W in centerline of black top

And is accepted as a careful and faithful
perpetuation of the position of the original corner.

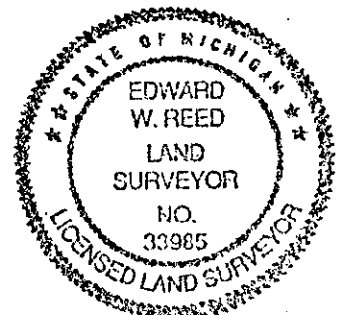

Signed by Edward W. Reed
Surveyor's Michigan License No. 33985

Date June 16, 1995