

SURVEY & REMONUMENTATION BRANCH COUNTY REMONUMENTATION CORNER

LAND CORNER RECORDATION CERTIFICATE

MAR 21 1997

Filing Requirement of Act 74, Mich. P.A. 1970

For corners in

BRANCH COMMISSION (County) Located In: Corner Code L-3

KINDERHOOK TWP.
 1. Public Land Survey T 8 S R 6 W
 T R
 T R
 T R
 T R

2. Property Controlling S T R
 in Section S T R
 3. Miscellaneous S T R
 Property in Sec. S T R

4. Lot No. _____, Recorded Plat _____
 5. Private Claims _____

"Liber 00003 Page 0086

STATE OF MICHIGAN
 Branch County
 Recorded

10-30-1996 09:22:12

Linda Lee Morrison-Mathews
 REGISTER OF DEEDS
 Register of Deeds Stamp & File Number

I, EDWARD W. REED, in a field survey on SEPTEMBER 17, 19 96, do hereby certify that under requirements of P.A. 74, Michigan P.A. of 1970, the corner points mentioned in lines 1 and 2 above were in conformance with regulations and rules therefore as required in the current manual of survey instructions of the United States Department of the Interior, Bureau of Land Management or by a decree of a Court of Law and/or that the corner points mentioned in lines 3, 4 and 5 above were in conformance with the rules of the Michigan Board of Land Surveyors or by a Decree of a Court of Law; established, re-established, monumented, re-monumented, recovered, found as expressed below:

NOTE: Not more than 4 corners, all in the same town and range, may be recorded on this certificate.

A	B	C	D	E	F	G	H	I	J	K	L	M
2	6	5	4	3	2	1						
3												
4	7	8	9	10	11	12						
5												
6	15	17	16	15	14	13						
7												
8	19	20	21	22	23	24						
9												
10	30	29	28	27	26	25						
11												
12	31	32	33	34	35	36						
13												


A. Description of original monument and accessories and/or subsequent restoration:
 QUARTER CORNER COMMON TO SECTIONS 1 & 12, T8S, R6W, KINDERHOOK TWP., BRANCH COUNTY, MI
 1828: R. CLARK, JR., DEP. SURVEYOR, CORNER SET
 1965: E.R. REED, COUNTY SURVEYOR, SURVEY TIED TO CORNER
 1975: DAVID BOONE, SURVEYOR, FOUND 1" IRON ROD, DUG BELOW, FOUND NOTHING ELSE, SET CASTING OVER IRON, RECORDED L.C.R.C. #139
 1988: DAVID GREER, SURVEYOR, FOUND 1" IRON BAR IN MONUMENT BOX, RECORDED L.C.R.C. #II-118

B. Description of corner evidence found and/or method applied in restoring or reestablishing corner:
 FOUND 1" x 18" IRON, REMOVED & SET 1/2" x 18" REBAR & REMONUMENTATION CAP
 RAISED MONUMENT BOX TO ROAD SURFACE WITH RINGS

ACCEPTED BY THE BRANCH COUNTY SURVEY PEER GROUP AS THE OFFICIAL CORNER UNDER MICHIGAN PUBLIC ACT 345 OF 1990 AT A MEETING HELD ON OCT. 09, 1996

E.R. Reed Co. Rep.
 E.R. REED

C. Description of monument for corner and accessories established to perpetuate locating the position of the corner:
 1" x 18" IRON WITH REMONUMENTATION CAP IN CAST IRON BOX
 S20W 133.73' TO NE CORNER OF HOUSE
 N70E 107.47' TO CENTER OF 12" RED OAK
 N63W 97.37' TO FACE OF POWER POLE
 N45E 44.74' TO SE CORNER OF CONCRETE PROJECT MARKER
 N55W 127.10" TO SE CORNER OF ATTACHED GARAGE
 S72E 104.1' TO FACE OF POWER POLE
 S80W 100.20' TO FACE OF POWER POLE

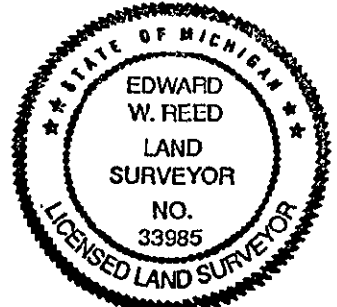

AND IS ACCEPTED AS A CAREFUL AND FAITHFUL PERPETUATION OF THE POSITION OF THE ORIGINAL CORNER.

Signed by Edward W. Reed Date SEPTEMBER 17, 1996
 Surveyor's Michigan License No. EDWARD W. REED 33985