

SURVEY & REMONUMENTATION

MAR 13 1998

SECTION

**BRANCH COUNTY REMONUMENTATION CORNER
LAND CORNER RECORDATION CERTIFICATE
Filing Requirement of Act 74, Mich. P.A. 1970**

For corners in

BRANCH _____ (County)	Located In:	Corner Code #
GILEAD TWP.		
1. Public Land Survey	T <u>8</u> S R <u>7</u> W	<u>I-5</u>
	T ___ R ___	_____
	T ___ R ___	_____
	T ___ R ___	_____
2. Property Controlling in Section	S ___ T ___ R ___	_____
	S ___ T ___ R ___	_____
3. Miscellaneous Property in Sec.	S ___ T ___ R ___	_____
	S ___ T ___ R ___	_____

STATE OF MICHIGAN
Branch County
Recorded

10-22-1997 09:55:17

Linda Lee Morrison-Mathews
REGISTER OF DEEDS
Liber **00003** Page **0153**

Register of Deeds Stamp & File Number

4. Lot No. _____, Recorded Plat _____
5. Private Claims _____

I, EDWARD W. REED, in a field survey on APRIL 29, 1997 do hereby state that under requirements of P.A. 74, Michigan P.A. of 1970, the corner points mentioned in lines 1 and 2 above were in conformance with regulations and rules therefore as required in the current manual of survey instructions of the United States Department of the Interior, Bureau of Land Management or by a decree of a Court of Law and /or that the corner points mentioned in lines 3, 4 and 5 above were in conformance with the rules of the Michigan Board of Land Surveyors or by a Decree of a Court of Law; established, re-established, monumented, recovered, found as expressed below:

NOTE: Not more than 2 corners, all in the same town and range, may be recorded on this certificate.

A. Description of original monument and accessories and/or subsequent restoration:
CORNER COMMON TO SECTIONS 10-11-14-15

- 1828: R. CLARK jr, - CORNER SET
- 1872: M. KNOWLES, DEPT SURVEYOR - BRICK UNDER STONE, ORIGINAL CORNER LOST, RESET FROM SOUTH 1/4, AND WEST 1/4 CORNERS.
- 1972: D. BOONE, SURVEYOR - SURVEY TIED TO CORNER, PROBABLE SET MONUMENT BOX
- 1984: L. GERSCHBACHER, SURVEYOR - FOUND 1/2" BAR IN PAVEMENT BOX, RECORDED IN LCRC # II-0073

B. Description of corner evidence found and/or method applied in restoring or reestablishing corner:

FOUND 1/2" IRON IN CI-MONUMENT BOX 4" BELOW ROAD SURFACE
NO STONE FOUND, POSSIBLY REMOVED DURING ROAD RECONSTRUCTION, WITH ORIGINAL SOIL REMOVED TO DEPTH OF ABOUT 24"

C. Description of monument for corner and accessories established to perpetuate locating the position of the corner:
1/2" REBAR IRON AND REMON CAP IN CI-MONUMENT RAISED TO ROAD SURFACE WITH RINGS

- TEL. PED., S34E 45.8' TO FACE
- POWER POLE, S70E 89.8' TO FACE
- CONCRETE ANCHOR POST, N48E 33.6' TO SW CORNER
- 17" WALNUT S20E 65.8' TO CENTER


AND IS ACCEPTED AS A CAREFUL AND FAITHFUL PERPETUATION OF THE POSITION OF THE ORIGINAL CORNER

Signed by Edward W. Reed

EDWARD W. REED

Date APRIL 29, 1997

Surveyor's Michigan License No. 33985

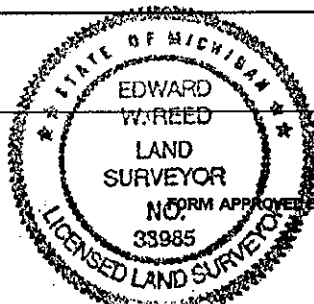

	A	B	C	D	E	F	G	H	I	J	K	L	M
1													
2		6		5		4		3		2		1	
3													
4		7		8		9		10		11		12	
5									●				
6		18		17		16		15		14		13	
7													
8		19		20		21		22		23		24	
9													
10		30		29		28		27		26		25	
11													
12		31		32		33		34		35		36	
13													

ACCEPTED BY THE BRANCH COUNTY SURVEY PEER GROUP AS THE OFFICIAL CORNER UNDER MICHIGAN PUBLIC ACT 345 OF 1890 AT A MEETING HELD ON 9-10-97

E. R. Reed, P.S. Co. Rep.
E.R. REED