

**SURVEY &  
REMONUMENTATION**

MAR 21 1997

COMMISSION

BRANCH COUNTY REMONUMENTATION CORNER

LAND CORNER RECORDATION CERTIFICATE STATE OF MICHIGAN

Filing Requirement of Act 74, Mich. P.A. 1970

Branch County  
Recorded

For corners in

BRANCH _____ (County) GILEAD TWP.	Located In:	Corner Code #
1. Public Land Survey	T <u>8</u> S R <u>7</u> W	<u>J-5</u>
	T _____ R _____	_____
	T _____ R _____	_____
	T _____ R _____	_____
2. Property Controlling in Section	S _____ T _____ R _____	_____
	S _____ T _____ R _____	_____
3. Miscellaneous Property in Sec.	S _____ T _____ R _____	_____
	S _____ T _____ R _____	_____
4. Lot No. _____, Recorded Plat _____		
5. Private Claims _____		

10-30-1996 09:19:55

Linda Lee Morrison-Mathews  
REGISTER OF DEEDS

Liber **00003** Page **0074**

Register of Deeds Stamp & File Number

I, EDWARD W. REED, in a field survey on JULY 5, 19 96, do hereby certify that under requirements of P.A. 74, Michigan P.A. of 1970, the corner points mentioned in lines 1 and 2 above were in conformance with regulations and rules therefore as required in the current manual of survey instructions of the United States Department of the Interior, Bureau of Land Management or by a decree of a Court of Law and/or that the corner points mentioned in lines 3, 4 and 5 above were in conformance with the rules of the Michigan Board of Land Surveyors or by a Decree of a Court of Law, established, re-established, monumented, re-monumented, recovered, found as expressed below:

**NOTE: Not more than 4 corners, all in the same town and range, may be recorded on this certificate.**

A. Description of original monument and accessories and/or subsequent restoration:

QUARTER CORNER COMMON TO SECTIONS 11 & 14, GILEAD TWP., T8S, R7W, BRANCH COUNTY, MI.

1828: R. CLARK, DEP. SURVEYOR, SET CORNER

CHAS. HAMILTON, COUNTY SURVEYOR, FOUND IRON & BRICK BY KNOWLES & BOTH US TREES

1974: E.R. REED, COUNTY SURVEYOR, FOUND 3/4" IRON SURROUNDED BY BROKEN BRICK, RESET 3/4" IRON IN CAST IRON BOX, RECORDED L.C.R.#0124

	A	B	C	D	E	F	G	H	I	J	K	L	M
2	6	5	4	3	2	1							
3													
4	7	8	9	10	11	12							
5													
6	18	17	16	15	14	13							
7													
8	19	20	21	22	23	24							
9													
10	30	29	28	27	26	25							
11													
12	31	32	33	34	35	36							
13													

B. Description of corner evidence found and/or method applied in restoring or reestablishing corner:


FOUND 3/4" IRON IN CAST IRON BOX, REMOVED IRON  
SET 1/2" x 18" IRON AND REMONUMENTATION CAP  
RAISED BOX TO ROAD SURFACE WITH 2 SMALL RINGS

ACCEPTED BY THE BRANCH COUNTY SURVEY PEER GROUP AS THE OFFICIAL CORNER UNDER MICHIGAN PUBLIC ACT 345 OF 1990 AT A MEETING HELD ON Oct. 9, 1996

E.R. Reed Co. Rep.  
E.R. REED

C. Description of monument for corner and accessories established to perpetuate locating the position of the corner:

1/2" x 18" REBAR WITH REMONUMENTATION CAP IN CAST IRON BOX  
S 29' TO FACE OF SQ. CONCRETE ANCHOR POST  
0.5" E of FENCELINE RUNNING S  
1.8' N OF C/L E-W ROAD  
S 29.75' TO FACE OF POWER POLE

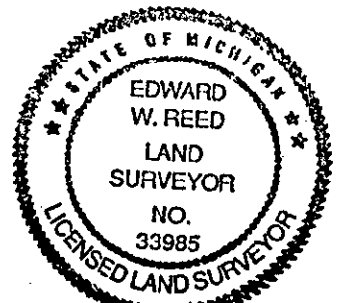

And is accepted as a careful and faithful perpetuation of the position of the original corner.

Signed by Edward W. Reed Date JULY 5, 1996  
Surveyor's Michigan License No. 33985