

SURVEY & REMONUMENTATION

MAR 21 1997

BRANCH COUNTY REMONUMENTATION CORNER SAND CORNER RECORDATION CERTIFICATE

Filing Requirement of Act 74, Mich. P.A. 1970

Liber **00003** Page **0075**

For corners in

BRANCH (County)	Located In:	Corner Code #
GILEAD TWP. 1. Public Land Survey	T 8 S R 7 W	K-5
	T _____ R _____	_____
	T _____ R _____	_____
	T _____ R _____	_____
2. Property Controlling in Section	S _____ T _____ R _____	_____
	S _____ T _____ R _____	_____
3. Miscellaneous Property in Sec.	S _____ T _____ R _____	_____
	S _____ T _____ R _____	_____

STATE OF MICHIGAN
Branch County
Recorded

10-30-1996 09:20:03

Linda Lee Morrison-Mathews
REGISTER OF DEEDS

Register of Deeds Stamp & File Number

4. Lot No. _____, Recorded Plat _____
5. Private Claims _____

	A	B	C	D	E	F	G	H	I	J	K	L	M
2	6		5		4		3		2		1		
3													
4	7		8		9		10		11		12		
5													
6	15		17		16		15		14		13		
7													
8	19		20		21		22		23		24		
9													
10	30		29		28		27		26		25		
11													
12	31		32		33		34		35		36		
13													

I, EDWARD W. REED, in a field survey on SEPTEMBER 17, 1996, do hereby certify that under requirements of P.A. 74, Michigan P.A. of 1970, the corner points mentioned in lines 1 and 2 above were in conformance with regulations and rules therefore as required in the current manual of survey instructions of the United States Department of the Interior, Bureau of Land Management or by a decree of a Court of Law and/or that the corner points mentioned in lines 3, 4 and 5 above were in conformance with the rules of the Michigan Board of Land Surveyors or by a Decree of a Court of Law; established, re-established, monumented, re-monumented, recovered, found as expressed below:


NOTE: Not more than 4 corners, all in the same town and range, may be recorded on this certificate.

A. Description of original monument and accessories and/or subsequent restoration:

CORNER COMMON TO SECTIONS 11, 12, 13 & 14, T8S, R7W, GILEAD TWP, BRANCH COUNTY, MI
1828: R. CLARK, JR., DEP. SURVEY, CORNER SET
1873: J.H. BENNETT, COUNTY SURVEYOR, "FOUND STONE WELL PLANTED"
1974: E.R. REED, COUNTY SURVEYOR, "FOUND POINTED STONE 18" BELOW ROAD SURFACE WITH BROKEN BRICK AROUND STONE." SET 5/8" x 10" IRON ROD IN MONUMENT BOX

B. Description of corner evidence found and/or method applied in restoring or reestablishing corner:

FOUND 5/8" x 10" IRON ROAD IN CAST IRON BOX
REMOVED IRON AND REPLACED IT WITH 1/2" x 18" REBAR AND REMONUMENTATION CAP
RAISED CAST IRON BOX TO ROAD SURFACE WITH RINGS

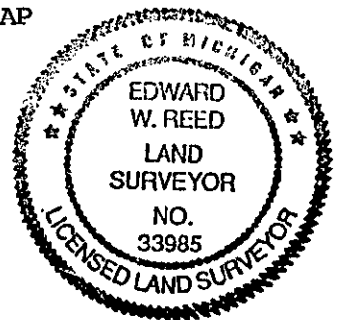

C. Description of monument for corner and accessories established to perpetuate locating the position of the corner:

1/2" x 18" REBAR WITH REMONUMENTATION CAP IN CAST IRON BOX
N2W 25.8' TO FACE OF WOOD ANCHOR POST
IN LINE WITH FENCE RUNNING NORTH
E 396.72' PIPE IN C/L OF ROAD (RECORDED AS 6 CHAINS EAST)
S60E 110.40' TO FACE OF POWER POLE

ACCEPTED BY THE BRANCH COUNTY SURVEY PEER GROUP AS THE OFFICIAL CORNER UNDER MICHIGAN PUBLIC ACT 345 OF 1996 AT A MEETING HELD ON Oct. 9, 1996

E.R. Reed Co. Rep.
E.R. REED

AND IS ACCEPTED AS A CAREFUL AND FAITHFUL PERPETUATION OF THE POSITION OF THE ORIGINAL CORNER.

Signed by Edward W. Reed Date SEPTEMBER 17, 1996
Surveyor's Michigan License No. 33985