

SURVEY & REMONUMENTATION

FEB 08 1999

SECTION

**BRANCH COUNTY REMONUMENTATION PROGRAM
LAND CORNER RECORDATION CERTIFICATE
Filing Requirement of Act 74, Mich. P.A. 1970**

For corners in

<u>BRANCH COUNTY</u> <u>NOBLE TOWNSHIP</u>	Located In:	Corner Code #
1. Public Land Survey	T <u>8</u> R <u>8</u>	<u>K-1</u>
	T <u> </u> R <u> </u>	<u> </u>
	T <u> </u> R <u> </u>	<u> </u>
	T <u> </u> R <u> </u>	<u> </u>
2. Property Controlling in Section	S <u> </u> T <u> </u> R <u> </u>	<u> </u>
	S <u> </u> T <u> </u> R <u> </u>	<u> </u>
3. Miscellaneous Property in Sec.	S <u> </u> T <u> </u> R <u> </u>	<u> </u>
	S <u> </u> T <u> </u> R <u> </u>	<u> </u>

STATE OF MICHIGAN
Branch County
Recorded

11-04-1998 15:48:52

Linda Lee Morrison-Mathews
REGISTER OF DEEDS

Register of Deeds Stamp & File Number

4. Lot No. _____, Recorded Plat _____

5. Private Claims _____

I, EDWARD W. REED, in a field survey on JULY 14, 1998 do hereby state that under requirements of P.A. 74, Michigan P.A. of 1970, the corner points mentioned in lines 1 and 2 above were in conformance with regulations and rules therefore as required in the current manual of survey instructions of the United States Department of the Interior, Bureau of Land Management or by a decree of a Court of Law and for that the corner points mentioned in lines 3, 4 and 5 above were in conformance with the rules of the Michigan Board of Land Surveyors or by a Decree of a Court of Law; established, re-established, monumented, recovered, found as expressed below:

NOTE: Not more than 2 corners, all in the same town and range, may be recorded on this certificate.

1	A	B	C	D	E	F	G	H	I	J	K	L	M
2		6		5		4		3		2		1	
3													
4		7		8		9		10		11		12	
5													
6		18		17		16		15		14		13	
7													
8		19		20		21		22		23		24	
9													
10		30		29		28		27		26		25	
11													
12		31		32		33		34		35		36	
13													

CORNER COMMON TO NOBLE TOWNSHIP, SECTIONS 1 AND 2 AND BRONSON TOWNSHIP, SECTIONS 35 AND 36

A. Description of original monument and accessories and/or subsequent restoration:

1825: G.L.O. FIELD NOTES OF JOHN MULLETT, D.S. - CORNER SET
1881: SURVEY BY C. HAMILTON, COUNTY SURVEYOR - STAKE
1882: SURVEY BY C. HAMILTON, COUNTY SURVEYOR - NO EVIDENCE OF CORNER, RE ESTABLISHED, PUT LONG STAKE WITH PLOW POINT OLD SECTION CORNER NOTES OF E.R. REED, CO SURVEYOR - 1" IRON PIPE

ACCEPTED BY THE BRANCH COUNTY SURVEY PEER GROUP AS THE OFFICIAL CORNER UNDER MICHIGAN PUBLIC ACT 345 OF 1990 AT A MEETING HELD ON 9-09-1998

E.R. Reed, Co Rep.

E.R. REED


B. Description of corner evidence found and/or method applied in restoring or reestablishing corner:

FOUND 1" IRON PIPE BELOW ROAD SURFACE
SET 1/2" X 18" REBAR IRON WITH REMON CAP IN CI-MONUMENT BOX FLUSH WITH ROAD SURFACE

C. Description of monument for corner and accessories established to perpetuate locating the position of the corner:

1/2" IRON WITH REMON CAP IN CI-MONUMENT BOX

POWER POLE, S 70 E 102.4' TO FACE
TEL. PED S 40 E 49.1' TO FACE
POWER POLE S 23 W 116.4' TO FACE
TEL. PED S 55 W 43.0'

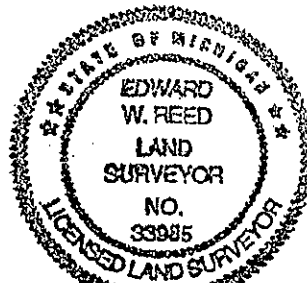

AND IS ACCEPTED AS THE BEST AVAILABLE EVIDENCE OF THE POSITION OF THE ORIGINAL CORNER

Signed by Edward W. Reed

EDWARD W, REED

Date SEPTEMBER 9, 1998
Liber 00005 Page 0234

Surveyor's Michigan License No. 33985