

SURVEY & REMONUMENTATION

FEB 08 1999

SECTION

**BRANCH COUNTY REMONUMENTATION PROGRAM
LAND CORNER RECORDATION CERTIFICATE
Filing Requirement of Act 74, Mich. P.A. 1970**

For corners in

BRANCH COUNTY
NOBLE TOWNSHIP

Located in:

Corner Code #

- | | | |
|------------------------------------|-------------------------|------------|
| 1. Public Land Survey | T <u>8</u> R <u>8</u> | <u>L-1</u> |
| | T _____ R _____ | _____ |
| | T _____ R _____ | _____ |
| | T _____ R _____ | _____ |
| 2. Property Controlling in Section | S _____ T _____ R _____ | _____ |
| | S _____ T _____ R _____ | _____ |
| 3. Miscellaneous Property in Sec. | S _____ T _____ R _____ | _____ |
| | S _____ T _____ R _____ | _____ |

STATE OF MICHIGAN
Branch County
Recorded

11-04-1998 15:49:05

Linda Lee Morrison-Mathews
REGISTER OF DEEDS

Register of Deeds Stamp & File Number

4. Lot No. _____, Recorded Plat _____

5. Private Claims _____

	A	B	C	D	E	F	G	H	I	J	K	L	M
1													
2		6		5		4		3		2		1	
3													
4		7		8		9		10		11		12	
5													
6		18		17		16		15		14		13	
7													
8		19		20		21		22		23		24	
9													
10		30		29		28		27		26		25	
11													
12		31		32		33		34		35		36	
13													

I, EDWARD W. REED, in a field survey on AUG 5, 1998 do hereby state that under requirements of P.A. 74, Michigan P.A. of 1970, the corner points mentioned in lines 1 and 2 above were in conformance with regulations and rules therefore as required in the current manual of survey instructions of the United States Department of the Interior, Bureau of Land Management or by a decree of a Court of Law and /or that the corner points mentioned in lines 3, 4 and 5 above were in conformance with the rules of the Michigan Board of Land Surveyors or by a Decree of a Court of Law; established, re-established, monumented, recovered, found as expressed below:

NOTE: Not more than 2 corners, all in the same town and range, may be recorded on this certificate.

CORNER COMMON TO BRONSON TOWNSHIP, SECTIONS 35 AND 36 AND NOBLE TOWNSHIP, SECTIONS 1 AND 2

A. Description of original monument and accessories and/or subsequent restoration:

- 1825: G.L.O. FIELD NOTES OF JOHN MULLETT, D.S.
- 1881: SURVEY BY C. HAMILTON, COUNTY SURVEYOR
- 1882: SURVEY BY C. HAMILTON, COUNTY SURVEYOR
- 1916: SURVEY BY D. W. DUDLEY, DEP. COUNTY SURVEYOR
- OLD SECTION CORNER FILE CARD FOR BRONSON TOWNSHIP (COMMON CORNER)

ACCEPTED BY THE BRANCH COUNTY SURVEY PEER GROUP AS THE OFFICIAL CORNER UNDER MICHIGAN PUBLIC ACT 345 OF 1990 AT A MEETING HELD ON 9-09-98

E.R. Reed, Co. Rep.
E.R. REED


B. Description of corner evidence found and/or method applied in restoring or reestablishing corner:

FOUND 1/2" IRON IN REMONUMENTATION BOX
SET REMONUMENTATION CAP ON IRON

C. Description of monument for corner and accessories established to perpetuate locating the position of the corner:

3/4" IRON WITH REMONUMENTATION CAP IN CAST IRON REMONUMENTATION BOX

- | | |
|------------------------------|--------------|
| TELEPHONE POLE (FACE OF) | S 50 E 52.2' |
| TELEPHONE PEDESTAL (FACE OF) | S 41 W 44.1' |
| POWER POLE (FACE OF) | S 73 W 80.5' |
| 36" MAPLE (CENTER OF) | N 33 E 60.2' |

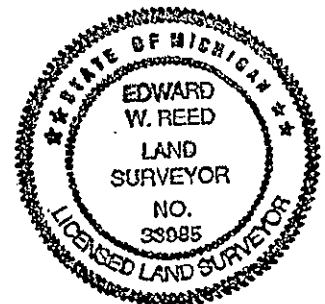

AND IS ACCEPTED AS A CAREFUL AND FAITHFUL PERPETUATION OF THE POSITION OF THE ORIGINAL CORNER

Signed by Edward W. Reed
EDWARD W. REED

Date SEPTEMBER 9, 1998
Liber 00003 Page 0236

Surveyor's Michigan License No. 33985