

SURVEY & REMONUMENTATION

1993

COMMISSION

CALHOUN COUNTY REMONUMENTATION

LAND CORNER RECORDATION CERTIFICATE
Filing Requirement of Act 74, Mich. P.A. 1970

RECORDED

19 1 00 PM 93

For corners in
CALHOUN
 (County)

Located In:

Corner Code #

- | | | | | | | | |
|------------------------------------|---|---|---|---|---|---|------|
| 1. Public Land Survey | T | 1 | S | R | 4 | W | C-11 |
| | T | | R | | | | |
| | T | | R | | | | |
| | T | | R | | | | |
| 2. Property Controlling in Section | S | | T | | R | | |
| | S | | T | | R | | |
| 3. Miscellaneous Property in Sec. | S | | T | | R | | |
| | S | | T | | R | | |

CLERK-REGISTER
 CALHOUN COUNTY, MICH.
 ANNE B. SCORLANDER

Register of Deeds Stamp & File Number

4. Lot No. _____, Recorded Plat _____
 5. Private Claims _____

I, DONALD J. DAVIS, in a field survey on OCTOBER 27, 19 93, do hereby certify that under requirements of P.A. 74, Michigan P.A. of 1970, the corner points mentioned in lines 1 and 2 above were in conformance with regulations and rules therefore as required in the current manual of survey instructions of the United States Department of the Interior, Bureau of Land Management or by a decree of a Court of Law and/or that the corner points mentioned in lines 3, 4 and 5 above were in conformance with the rules of the Michigan Board of Land Surveyors or by a Decree of a Court of Law; established, re-established, monumented, re-monumented, recovered, found as expressed below:

NOTE: Not more than 4 corners, all in the same town and range, may be recorded on this certificate.

A	B	C	D	E	F	G	H	I	J	K	L	N
2	6	5	4	3	2	1						
3												
4	7	8	9	10	11	12						
5												
6	16	17	16	15	14	13						
7												
8	19	20	21	22	23	24						
9												
10	30	29	28	27	26	25						
11												
12	31	32	33	34	35	36						
13												

- A. Description of original monument and accessories and/or subsequent restoration:
 TILE SET IN RESURVEY ON CENTERLINE E & W DRAIN AND ON WEST LINE OF DRAIN NORTH.
 10" ELM S 45° W 82 LINKS.
 12" ELM S 82°W 138 LINKS.
 5/8" IRON SET IN 1960 BY STACK L.S.# 10707.
 8" ASH S 10° E 17.40'
 6" ELM S 40° W 22.50'
 18" ELM NORTH 31.34'
- B. Description of corner evidence found and/or method applied in restoring or reestablishing corner:
 FOUND 5/8" IRON IN CENTER OF DRAIN AS CALLED FOR BY STACK.
 WATER IN DRAIN 1 FOOT DEEP.
 ACCEPTED THIS AS A GOOD PERPETUATION OF THE LOCATION OF THE ORIGINAL CORNER.


LIBER 1716 PAGE 626

- C. Description of monument for corner and accessories established to perpetuate locating the position of the corner:
 SET BERTISEN MONUMENT OVER 5/8" IRON IN DRAIN. PLACED ROCKS AROUND.
 CENTERLINE DRAIN EAST & WEST.
 WEST EDGE DRAIN NORTH.
 NAIL & TAG 10" ELM S 45° W 13.80'.
 NAIL & TAG 12" ASH SOUTH 18.50'.
 NAIL & TAG 10" ELM S 80° E 23.30'.

Signed by

Donald J. Davis

Surveyor's Michigan License No. 17617

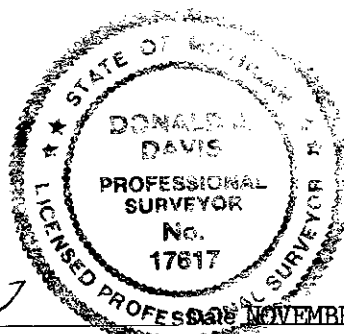

NOVEMBER 2, 1993