

SURVEY & REMONUMENTATION

1993

CALHOUN COUNTY REMONUMENTATION

RECORDED

COMMISSION

LAND CORNER RECORDATION CERTIFICATE
Filing Requirement of Act 74, Mich. P.A. 1970

Nov 14 1 00 PM 93

For corners in

<u>Calhoun County</u> <small>(County)</small>	Located In:	Corner Code #
1. Public Land Survey	T <u>1 S</u> R <u>4 W</u>	<u>C-12</u>
	T _____ R _____	_____
	T _____ R _____	_____
	T _____ R _____	_____
2. Property Controlling in Section	S _____ T _____ R _____	_____
	S _____ T _____ R _____	_____
3. Miscellaneous Property in Sec.	S _____ T _____ R _____	_____
	S _____ T _____ R _____	_____

CLERK-REGISTER
 CALHOUN COUNTY, MICH.
 ANNE B. HOI-ANDER

Register of Deeds Stamp & File Number

4. Lot No. _____, Recorded Plat _____
 5. Private Claims _____

	A	B	C	D	E	F	G	H	I	J	K	L	M
2	6	5	4	3	2	1							
3													
4	7	8	9	10	11	12							
5													
6	18	17	16	15	14	13							
7													
8	19	20	21	22	23	24							
9													
10	30	29	28	27	26	25							
11													
12	31	32	33	34	35	36							
13													

I, Donald J. Davis, in a field survey on October 28, 1993, do hereby certify that under requirements of P.A. 74, Michigan P.A. of 1970, the corner points mentioned in lines 1 and 2 above were in conformance with regulations and rules therefore as required in the current manual of survey instructions of the United States Department of the Interior, Bureau of Land Management or by a decree of a Court of Law and/or that the corner points mentioned in lines 3, 4 and 5 above were in conformance with the rules of the Michigan Board of Land Surveyors or by a Decree of a Court of Law; established, re-established, monumented, re-monumented, recovered, found as expressed below:

NOTE: Not more than 4 corners, all in the same town and range, may be recorded on this certificate.

A. Description of original monument and accessories and/or subsequent restoration:

Tile set in resurvey of 1889 by Gifford. Gifford found old sleigh shoe placed by Raper to preserve corner.

- 7" Elm N 01° E 32 Links.
- 8" Butternut N 40° W 53 Links.

Tile found by Stack in 1972, recorded in Liber 999, page 469 and used for surveys of adjacent land.

B. Description of corner evidence found and/or method applied in restoring or reestablishing corner:


Corner buried 6 foot by road construction in 1980.
 Used Stack irons on surveys of adjacent land to reset location in new road.
 Matches one witness remaining.
 14" Oak N 65° W 56.94'

LIBER 1716 PAGE 628

C. Description of monument for corner and accessories established to perpetuate locating the position of the corner:

Set Berntsen monument and monument box at corner.

- Nail & Tag 20" Oak N 80° W 53.10'
- Nail & Tag Twin 10" Elm North 68.88'
- Nail & Tag 20" Oak S 80° E 141.20'
- Nail & Tag Quad 10" Elm S 35° W 84.53'
- 8' North of centerline of road.
- Tree row and fence North.

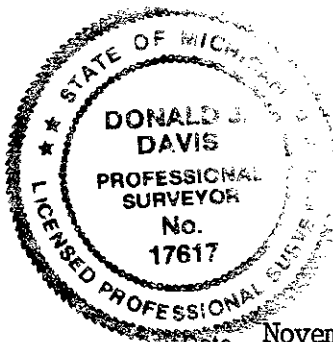

Signed by Donald J. Davis

Date November 10, 1993

Surveyor's Michigan License No. 17617