

SURVEY & REMONUMENTATION

1993

CALHOUN COUNTY REMONUMENTATION

COMMISSION

LAND CORNER RECORDATION CERTIFICATE  
Filing Requirement of Act 74, Mich. P.A. 1970

RECORDED

Nov 19 12 58 PM 93

CLERK-REGISTRAR  
CALHOUN COUNTY  
ANNE H. NORTON

For corners in  
CALHOUN

(County)

Located In:

Corner Code #

- 1. Public Land Survey      T 1 S    R 4 W      C-13
- T        R
- T        R
- T        R
- 2. Property Controlling    S        T        R
- in Section                S        T        R
- 3. Miscellaneous            S        T        R
- Property in Sec.         S        T        R

Register of Deeds Stamp & File Number

- 4. Lot No. \_\_\_\_\_, Recorded Plat \_\_\_\_\_
- 5. Private Claims \_\_\_\_\_

	A	B	C	D	E	F	G	H	I	J	K	L	M
2	6		5		4		3		2		1		
3													
4	7		8		9		10		11		12		
5													
6	18		17		16		15		14		13		
7													
8	19		20		21		22		23		24		
9													
10	30		29		28		27		26		25		
11													
12	31		32		33		34		35		36		
13													

I, DONALD J. DAVIS, in a field survey on OCTOBER 27, 1993, do hereby certify that under requirements of P.A. 74, Michigan P.A. of 1970, the corner points mentioned in lines 1 and 2 above were in conformance with regulations and rules therefore as required in the current manual of survey instructions of the United States Department of the Interior, Bureau of Land Management or by a decree of a Court of Law and/or that the corner points mentioned in lines 3, 4 and 5 above were in conformance with the rules of the Michigan Board of Land Surveyors or by a Decree of a Court of Law; established, re-established, monumented, re-monumented, recovered, found as expressed below:

**NOTE: Not more than 4 corners, all in the same town and range, may be recorded on this certificate.**

A. Description of original monument and accessories and/or subsequent restoration:

TILE SET IN RESURVEY TO REPLACE STONE SET BY G. LEWIS, COUNTY SURVEYOR.  
AT NORTH SIDE OF ROAD TRACK.  
10" ASPEN N 7 1/4° W 64 LINKS.  
MAPLE S 28 1/2° W 61 LINKS.


B. Description of corner evidence found and/or method applied in restoring or reestablishing corner:

FOUND IRON AND ROCKS AT NORTH EDGE ROAD 4 FEET UNDER PAVING.  
NO WITNESSES REMAIN.  
ACCEPTED THIS CORNER AS PERPETUATION OF ORIGINAL CORNER.

LIBER 1716 PAGE 618

C. Description of monument for corner and accessories established to perpetuate locating the position of the corner:

SET BERNISEN MONUMENT IN MONUMENT BOX.  
NAIL & TAG 32" RED OAK N 60° E 37.86'.  
NAIL & TAG 24" MAPLE N 40° W 23.00'.  
NAIL & TAG 28" CHERRY S 10° E 50.64'.  
NAIL & TAG TWIN 26" MAPLE S 35° W 39.65'.  
4" STEEL FENCE CORNER N 10° E 19.67'.

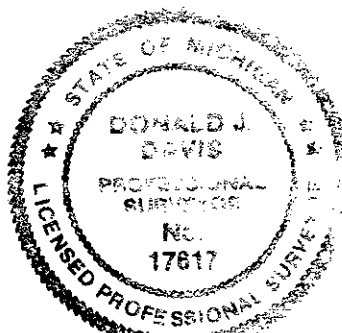

Signed by Donald J. Davis  
Surveyor's Michigan License No. 17617

Date NOVEMBER 2, 1993