

SURVEY &
REMONUMENTATION

1993

CALHOUN COUNTY REMONUMENTATION

RECORDED

COMMISSION

LAND CORNER RECORDATION CERTIFICATE
Filing Requirement of Act 74, Mich. P.A. 1970

NOV 14 1 00 PM '93

For corners in

<u>Calhoun County</u> <small>(County)</small>	Located In:	Corner Code #
1. Public Land Survey	T <u>1</u> S R <u>4</u> W	<u>D-11</u>
	T _____ R _____	_____
	T _____ R _____	_____
	T _____ R _____	_____
2. Property Controlling in Section	S _____ T _____ R _____	_____
	S _____ T _____ R _____	_____
3. Miscellaneous Property in Sec.	S _____ T _____ R _____	_____
	S _____ T _____ R _____	_____

CLERK-REGISTRAR
CALHOUN COUNTY, MICH.
ANNE D. MURPHY

Register of Deeds Stamp & File Number

4. Lot No. _____, Recorded Plat _____
5. Private Claims _____

	A	B	C	D	E	F	G	H	I	J	K	L	M
2	6	5	4	3	2	1							
3													
4	7	8	9	10	11	12							
5													
6	18	17	16	15	14	13							
7													
8	19	20	21	22	23	24							
9													
10	30	29	28	27	26	25							
11													
12	31	32	33	34	35	36							
13													

Donald J. Davis in a field survey on October 28, 1993, do hereby certify that under requirements of P.A. 74, Michigan P.A. of 1970, the corner points mentioned in lines 1 and 2 above were in conformance with regulations and rules therefore as required in the current manual of survey instructions of the United States Department of the Interior, Bureau of Land Management or by a decree of a Court of Law and/or that the corner points mentioned in lines 3, 4 and 5 above were in conformance with the rules of the Michigan Board of Land Surveyors or by a Decree of a Court of Law; established, re-established, monumented, re-monumented, recovered, found as expressed below:

NOTE: Not more than 4 corners, all in the same town and range, may be recorded on this certificate.

A. Description of original monument and accessories and/or subsequent restoration:

Tile set in resurvey by Gifford in 1889.
From parole evidence.
No witness near.

5/8" iron set in tile chips by Stack #10707 in 1972.
30" Elm West 13.36'
26" Elm N 15° W 33.19'

B. Description of corner evidence found and/or method applied in restoring or reestablishing corner:


Found 5/8" iron 4' long in tile chips with rocks around.

Matches description of corner so accepted as perpetuation of original corner.

LIBER 1716 PAGE 624

C. Description of monument for corner and accessories established to perpetuate locating the position of the corner:

Set Berntsen monument with brass cap.
Nail & tag Twin 10" Elm N 10° E 12.47'
Nail & Tag 20" Elm S 30° W 14.60'
Nail & Tag 10" Elm N 50° W 21.50'
Nail & Tag 8" Elm East 19.80'

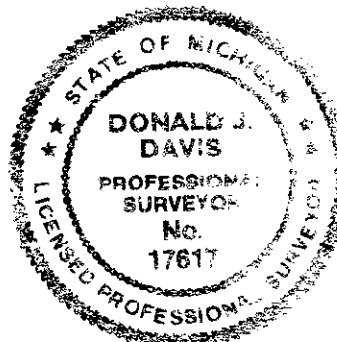

Signed by Donald J. Davis

Date November 4, 1993

Surveyor's Michigan License No. 17617