

SURVEY &
REMONUMENTATION

1993

CALHOUN COUNTY REMONUMENTATION

RECORDED

COMMISSION

LAND CORNER RECORDATION CERTIFICATE

Filing Requirement of Act 74, Mich. P.A. 1970

Nov 14 1 00 PM '93

CLERK-REGISTRAR
CALHOUN COUNTY, MI
ANNE S. HOPKINS

For corners in

Calhoun
(County)

Located In:

Corner Code ##

- | | | |
|---------------------------------------|-------------------------|-------|
| 1. Public Land Survey | T 1 S R 4 W | D-13 |
| | T _____ R _____ | _____ |
| | T _____ R _____ | _____ |
| | T _____ R _____ | _____ |
| 2. Property Controlling
in Section | S _____ T _____ R _____ | _____ |
| | S _____ T _____ R _____ | _____ |
| 3. Miscellaneous
Property in Sec. | S _____ T _____ R _____ | _____ |
| | S _____ T _____ R _____ | _____ |

Register of Deeds Stamp & File Number

4. Lot No. _____, Recorded Plat _____
5. Private Claims _____

Donald J. Davis, in a field survey on October 27, 1993

do hereby certify that under requirements of P.A. 74, Michigan P.A. of 1970, the corner points mentioned in lines 1 and 2 above were in conformance with regulations and rules therefore as required in the current manual of survey instructions of the United States Department of the Interior, Bureau of Land Management or by a decree of a Court of Law and/or that the corner points mentioned in lines 3, 4 and 5 above were in conformance with the rules of the Michigan Board of Land Surveyors or by a Decree of a Court of Law; established, re-established, monumented, re-monumented, recovered, found as expressed below:

NOTE: Not more than 4 corners, all in the same town and range, may be recorded on this certificate.

A. Description of original monument and accessories and/or subsequent restoration:

Title set in resurvey on the north side of a crossway in line with old ditch to north.

3" Elm N 41° W 30 links.

9" Elm South 73 links.

1/2" Iron 3' South of North edge paving by Stack.

12" Ash S 15° E 39.29'

26" stump N 45° W 20.10' (Gone).

B. Description of corner evidence found and/or method applied in restoring or reestablishing corner:


Found iron rod 3 foot south of north edge pavement in line with old ditch to north.

Accepted corner as established by Stack and as used by other surveyors in this area.

	A	B	C	D	E	F	G	H	I	J	K	L	M
2	6	5	4	3	2	1							
3													
4	7	8	9	10	11	12							
5													
6	18	17	16	15	14	13							
7													
8	19	20	21	22	23	24							
9													
10	30	29	28	27	26	25							
11													
12	31	32	33	34	35	36							
13													

LIBER 1716 PAGE 621

- C. Description of monument for corner and accessories established to perpetuate locating the position of the corner:
- Set Berntsen monument in monument box in line with old ditch North.
- Nail & tag 14" Ash S 15° E 39.80'.
- Nail & Tag 12" Elm N 65° E 76.60'.
- Nail & Tag 24" Burr Oak S 80° W 239.50'.
- Nail & tag 3" Pine N 40° W 35.90'.
- 22.13' West of 5/8" iron at Sheridan Corner 3 feet South of North edge of pavement.

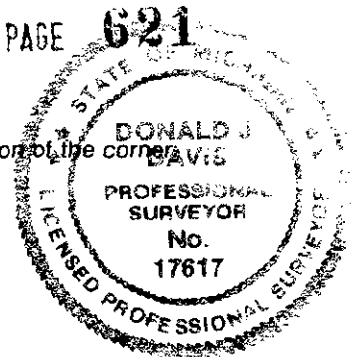

Signed by Donald J. Davis

Date November 3, 1993

Surveyor's Michigan License No. 17617