

SURVEY &
REMONUMENTATION

1993

CALHOUN COUNTY REMONUMENTATION

COMMISSION

LAND CORNER RECORDATION CERTIFICATE
Filing Requirement of Act 74, Mich. P.A. 1970

RECORDED
NOV 15 1 00 PM '93

For corners in

<u>Calhoun</u> <small>(County)</small>	Located In:	Corner Code #:
1. Public Land Survey	T <u>1 S</u> R <u>4 W</u>	<u>E-13</u>
	T _____ R _____	_____
	T _____ R _____	_____
	T _____ R _____	_____
2. Property Controlling in Section	S _____ T _____ R _____	_____
	S _____ T _____ R _____	_____
3. Miscellaneous Property in Sec.	S _____ T _____ R _____	_____
	S _____ T _____ R _____	_____
4. Lot No. _____, Recorded Plat _____		
5. Private Claims _____		

REGISTERED
CALHOUN COUNTY
ANN ARBOR
REGISTER OF DEEDS
Stamp & File Number

Donald J. Davis, in a field survey on October 27, 1993.
do hereby certify that under requirements of P.A. 74, Michigan P.A. of 1970, the corner points mentioned in lines 1 and 2 above were in conformance with regulations and rules therefore as required in the current manual of survey instructions of the United States Department of the Interior, Bureau of Land Management or by a decree of a Court of Law and/or that the corner points mentioned in lines 3, 4 and 5 above were in conformance with the rules of the Michigan Board of Land Surveyors or by a Decree of a Court of Law; established, re-established, monumented, re-monumented, recovered, found as expressed below:

A	B	C	D	E	F	G	H	I	J	K	L	M
2	6	5	4	3	2	1						
3												
4	7	8	9	10	11	12						
5												
6	18	17	16	15	14	13						
7												
8	19	20	21	22	23	24						
9												
10	30	29	28	27	26	25						
11												
12	31	32	33	34	35	36						
13												

NOTE: Not more than 4 corners, all in the same town and range, may be recorded on this certificate.

A. Description of original monument and accessories and/or subsequent restoration:

Title set in resurvey by distance from Sheridan Corner.
14" Yellow Oak N 01° E 68 Links.
14" Yellow Oak S 84° E 142 Links.
R.R. Spike by J. Stack 3' South of centerline, 33' West of "T" iron on Sheridan corner.
14" Hickory S 70° E 75.38'
26" Hickory S 30° E 161.94'

Original tile destroyed by road construction.


B. Description of corner evidence found and/or method applied in restoring or reestablishing corner:

Found R.R. Spike as witnessed by Stack.
3 foot South of centerline and 33 feet West of Sheridan corner.
Accepted this as local perpetuation of original corner. Corner has been used for surveys in this area.

LIBER 1716 PAGE 622

C. Description of monument for corner and accessories established to perpetuate locating the position of the corner:

Set Berntsen monument in monument box.
Nail & Tag 18" Hickory S 70° E 75.28'
Nail & Tag 26" Hickory S 30° E 161.94'
Nail & Tag Utility pole S 45° W 109.95'
Nail & Tag 16" Ash North 39.88'
"T" iron East 33.0'

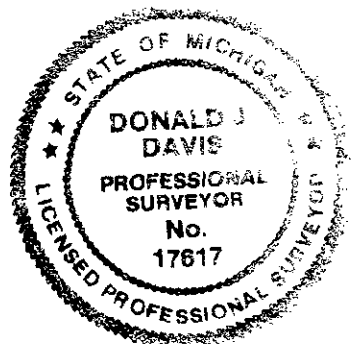

Signed by Donald J. Davis

Date November 3, 1993

Surveyor's Michigan License No. 17617