

SURVEY &  
REMONUMENTATION

1993

CALHOUN COUNTY REMONUMENTATION

COMMISSION

LAND CORNER RECORDATION CERTIFICATE  
Filing Requirement of Act 74, Mich. P.A. 1970

RECORDED  
NOV 15 12 55 PM '93

For corners in

Calhoun County  
(County)

Located In:

Corner Code #

- |                                       |                           |             |
|---------------------------------------|---------------------------|-------------|
| 1. Public Land Survey                 | T <u>1</u> S R <u>4</u> W | <u>F-11</u> |
|                                       | T _____ R _____           | _____       |
|                                       | T _____ R _____           | _____       |
|                                       | T _____ R _____           | _____       |
| 2. Property Controlling in Section    | S _____ T _____ R _____   | _____       |
|                                       | S _____ T _____ R _____   | _____       |
| 3. Miscellaneous Property in Sec.     | S _____ T _____ R _____   | _____       |
|                                       | S _____ T _____ R _____   | _____       |
| 4. Lot No. _____, Recorded Plat _____ |                           |             |
| 5. Private Claims _____               |                           |             |

CLERK-REGISTRAR  
CALHOUN COUNTY, MICHIGAN  

Register of Deeds Stamp & File Number

I, Donald J. Davis, in a field survey on October 28, 1993

do hereby certify that under requirements of P.A. 74, Michigan P.A. of 1970, the corner points mentioned in lines 1 and 2 above were in conformance with regulations and rules therefore as required in the current manual of survey instructions of the United States Department of the Interior, Bureau of Land Management or by a decree of a Court of Law and/or that the corner points mentioned in lines 3, 4 and 5 above were in conformance with the rules of the Michigan Board of Land Surveyors or by a Decree of a Court of Law; established, re-established, monumented, re-monumented, recovered, found as expressed below:

**NOTE: Not more than 4 corners, all in the same town and range, may be recorded on this certificate.**

	A	B	C	D	E	F	G	H	I	J	K	L	M
2	6		5		4		3		2		1		
3													
4	7		8		9		10		11		12		
5													
6	18		17		16		15		14		13		
7													
8	19		20		21		22		23		24		
9													
10	30		29		28		27		26		25		
11													
12	31		32		33		34		35		36		
13													

A. Description of original monument and accessories and/or subsequent restoration:

Tile set in resurvey by Gifford in 1889. Fence line East and West and North and South. No witnesses near.

Found tile 1972, placed 5/8" iron at tile in East and West fence. No witnesses near.

B. Description of corner evidence found and/or method applied in restoring or reestablishing corner:

Fence row removed for farming.  
Corner located replaced by using surveys done when corner existed.

Reset corner in open plowed field, found rocks 3 feet under field.

Corner is N 01°-41'-16" E 5302.31' from South 1/2 Post.

Corner is S 89°-05'-00" E 2644.78' from Northwest corner of section.


LIBER 1716 PAGE 617

C. Description of monument for corner and accessories established to perpetuate locating the position of the corner:

Set Harrison monument 1 1/2 feet under surface of plowed field.

No witnesses near. ( See Above),

Edge of woods to South and 1170' East of 26 Mile Road.

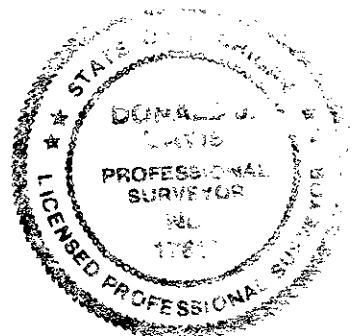

Signed by Donald J. Davis  
Surveyor's Michigan License No. 17617

Date November 10, 1993