

SURVEY &
REMONUMENTATION

1993

Calhoun County Remonumentation

RECORDED

COMMISSION

LAND CORNER RECORDATION CERTIFICATE
Filing Requirement of Act 74, Mich. P.A. 1970

Nov 19 1 00 PM '93

For corners in

<u>Calhoun County</u> (County)	Located In:	Corner Code #
1. Public Land Survey	T <u>1</u> S <u>4</u> R <u>4</u> W	<u>F-13</u>
	T _____ R _____	_____
	T _____ R _____	_____
	T _____ R _____	_____
2. Property Controlling in Section	S _____ T _____ R _____	_____
	S _____ T _____ R _____	_____
3. Miscellaneous Property in Sec.	S _____ T _____ R _____	_____
	S _____ T _____ R _____	_____
4. Lot No. _____, Recorded Plat _____		
5. Private Claims _____		

CLERK-REGISTRAR
CALHOUN COUNTY, MICH.
ANNE B. BLANKENBEE

Register of Deeds Stamp & File Number

I, Donald J. Davis, in a field survey on November 1, 19 93, do hereby certify that under requirements of P.A. 74, Michigan P.A. of 1970, the corner points mentioned in lines 1 and 2 above were in conformance with regulations and rules therefore as required in the current manual of survey instructions of the United States Department of the Interior, Bureau of Land Management or by a decree of a Court of Law and/or that the corner points mentioned in lines 3, 4 and 5 above were in conformance with the rules of the Michigan Board of Land Surveyors or by a Decree of a Court of Law; established, re-established, monumented, re-monumented, recovered, found as expressed below:

	A	B	C	D	E	F	G	H	I	J	K	L	M
2	6	5	4	3	2	1							
3													
4	7	8	9	10	11	12							
5													
6	18	17	16	15	14	13							
7													
8	19	20	21	22	23	24							
9													
10	30	29	28	27	26	25							
11													
12	31	32	33	34	35	36							
13													

NOTE: Not more than 4 corners, all in the same town and range, may be recorded on this certificate.

A. Description of original monument and accessories and/or subsequent restoration:

Tile Set in resurvey by Gifford in 1889. He found old wood stake from Government bearing tree stumps.

- 9" White Oak S 73° W 49 Links.
- 8" Hickory N 78° W 211 Links.

B. Description of corner evidence found and/or method applied in restoring or reestablishing corner:

Ran mile between SE and SW corner of section and set point on line at 1/2 distance.


Corner has not been used or recorded in any records.

LIBER 1716 PAGE 627

C. Description of monument for corner and accessories established to perpetuate locating the position of the corner:

Set Berntsen monument and monument box.
9.0' South of centerline of paving.

- Nail & tag Twin 8" Cherry N 45° W 52.27'
- Nail & tag Power pole N 75° W 135.90'
- Nail & tag 12" Elm S 45° W 41.92'
- Nail & tag 16" Hickory S 50° E 36.44'

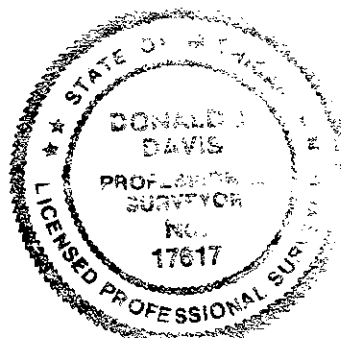

Signed by Donald J. Davis

Date November 10, 1993

Surveyor's Michigan License No. 17617