

SURVEY &  
REMONUMENTATION

1993

CALHOUN COUNTY REMONUMENTATION

COMMISSION

LAND CORNER RECORDATION CERTIFICATE  
Filing Requirement of Act 74, Mich. P.A. 1970

RECORDED

NOV 15 1 00 PM '93

For corners in  
CALHOUN

(County)

Located In:

Corner Code #

- |                                    |                           |             |
|------------------------------------|---------------------------|-------------|
| 1. Public Land Survey              | T <u>1</u> S R <u>4</u> W | <u>G-12</u> |
|                                    | T _____ R _____           | _____       |
|                                    | T _____ R _____           | _____       |
|                                    | T _____ R _____           | _____       |
| 2. Property Controlling in Section | S _____ T _____ R _____   | _____       |
|                                    | S _____ T _____ R _____   | _____       |
| 3. Miscellaneous Property in Sec.  | S _____ T _____ R _____   | _____       |
|                                    | S _____ T _____ R _____   | _____       |

CLERK-REGISTERED  
CALHOUN COUNTY  
ANNE D. ROSS

Register of Deeds Stamp & File Number

4. Lot No. \_\_\_\_\_, Recorded Plat \_\_\_\_\_  
5. Private Claims \_\_\_\_\_

	A	B	C	D	E	F	G	H	I	J	K	L	M
2	6	5	4	3	2	1							
3													
4	7	8	9	10	11	12							
5													
6	18	17	16	15	14	13							
7													
8	19	20	21	22	23	24							
9													
10	30	29	28	27	26	25							
11													
12	31	32	33	34	35	36							
13													

DONALD J. DAVIS, in a field survey on OCTOBER 27, 19 93, do hereby certify that under requirements of P.A. 74, Michigan P.A. of 1970, the corner points mentioned in lines 1 and 2 above were in conformance with regulations and rules therefore as required in the current manual of survey instructions of the United States Department of the Interior, Bureau of Land Management or by a decree of a Court of Law and/or that the corner points mentioned in lines 3, 4 and 5 above were in conformance with the rules of the Michigan Board of Land Surveyors or by a Decree of a Court of Law; established, re-established, monumented, re-monumented, recovered, found as expressed below:

**NOTE: Not more than 4 corners, all in the same town and range, may be recorded on this certificate.**

A. Description of original monument and accessories and/or subsequent restoration:

TILE SET IN RESURVEY FROM OLD STONE WALL ON WEST.

18" YELLOW OAK S 23½° W 107 LINKS GONE

10" HICKORY N 36-¾° E 83 LINKS GONE

FOUND 1½" IRON PIPE IN 1975. CORNER RECORDED IN LIBER 1218, PAGE 22.

8" HICKORY N 40° W 59.30'

26" OAK N 35° E 63.45'

12" OAK S 40° E 96.85'

B. Description of corner evidence found and/or method applied in restoring or reestablishing corner:

FOUND 1½" PIPE 6" UNDER GRAVEL ROAD.

CORNER HAS BEEN USED FOR SURVEYS IN SECTIONS EAST AND WEST SINCE 1972.

ACCEPTED CORNER AS LOCAL PERPETUATION OF ORIGINAL CORNER.

LIBER 1716 PAGE 625

C. Description of monument for corner and accessories established to perpetuate locating the position of the corner:

SET HARRISON MONUMENT 6" UNDER GRAVEL ROAD WITH ROCKS AROUND.


DNR TAG 24" BURR OAK S 58° E 34.05'

DNR TAG 20" RED OAK N 45° W 47.04'

NE CORNER R.R. RAIL POST WEST 36.75'

NAIL & TAG 18" WHITE OAK N 30° W 95.25'

NAIL & TAG 18" BURR OAK S 40° E 46.85'

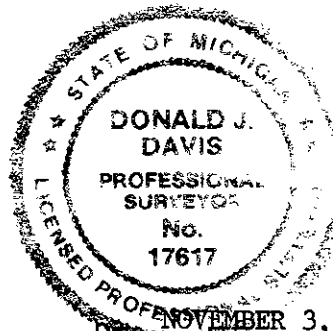

Signed by

*Donald J. Davis*

Date: NOVEMBER 3, 1993

Surveyor's Michigan License No. 17617