

SURVEY &  
REMONUMENTATION

1993

CALHOUN COUNTY REMONUMENTATION

COMMISSION

LAND CORNER RECORDATION CERTIFICATE  
Filing Requirement of Act 74, Mich. P.A. 1970

For corners in

CALHOUN  
(County)

Located In:

Corner Code #

1. Public Land Survey

T 1 S R 5 W

A-9

T R

T R

T R

2. Property Controlling  
in Section

S T R

S T R

3. Miscellaneous  
Property in Sec.

S T R

S T R

4. Lot No. \_\_\_\_\_, Recorded Plat \_\_\_\_\_

5. Private Claims \_\_\_\_\_

CLERK-REGISTER  
 CALHOUN COUNTY, MICH.  
 ANNE R. NORLANDER  
 Oct 26 10 15 AM '93

RECORDED

Register of Deeds Stamp & File Number

I, DONALD J. DAVIS, in a field survey on OCTOBER 18, 1993, do hereby certify that under requirements of P.A. 74, Michigan P.A. of 1970, the corner points mentioned in lines 1 and 2 above were in conformance with regulations and rules therefore as required in the current manual of survey instructions of the United States Department of the Interior, Bureau of Land Management or by a decree of a Court of Law and/or that the corner points mentioned in lines 3, 4 and 5 above were in conformance with the rules of the Michigan Board of Land Surveyors or by a Decree of a Court of Law; established, re-established, monumented, re-monumented, recovered, found as expressed below:

**NOTE: Not more than 4 corners, all in the same town and range, may be recorded on this certificate.**

A. Description of original monument and accessories and/or subsequent restoration:

TILE SET IN LAKE BY GIFFORD IN 1892.  
NO WITNESSES NEAR.


B. Description of corner evidence found and/or method applied in restoring or reestablishing corner:

NO EVIDENCE OF CORNER FOUND.  
FOUND OLD FENCE RUNNING EAST AND WEST BURIED 6" IN GROUND. SET CORNER POST USING OLD FENCE AS NORTH LINE AND EXTENDING LINE NORTH FROM SOUTHWEST CORNER THROUGH WEST 1/4 POST.

C. Description of monument for corner and accessories established to perpetuate locating the position of the corner:

SET BERNTSEN MONUMENT WITH BRASS CAP AT POINT IN OLD FENCE. CORNER SET 2669.46 FEET NORTH OF WEST 1/4 POST.  
12" TAMARACK S 10° W 35.5'.  
10" TAMATAACK S 40° E 31.2'.  
50' SOUTH OF OPEN WATERS.  
245' NORTH OF EDGE OF HIGH GROUND.  
STEEL FENCE POSTS AND ROCKS AROUND MONUMENT.

LIBER 1711 PAGE 083

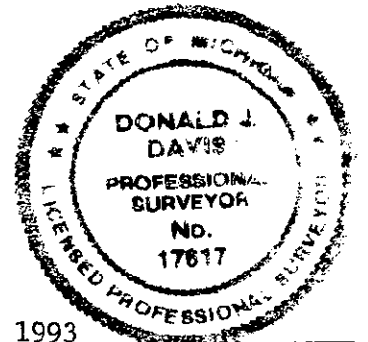

Signed by Donald J. Davis

Date OCTOBER 20, 1993

Surveyor's Michigan License No. 17617

	A	B	C	D	E	F	G	H	I	J	K	L
2	6	5	4	3	2	1						
3												
4	7	8	9	10	11	12						
5												
6	18	17	16	15	14	13						
7												
8	19	20	21	22	23	24						
9												
10	30	29	28	27	26	25						
11												
12	31	32	33	34	35	36						