

1993

REMONUMENTATION

COMMISSION

LAND CORNER RECORDATION CERTIFICATE
Filing Requirement of Act 74, Mich. P.A. 1970

Oct 6 9 47 AM '93

CLERK-REGISTER
CALHOUN COUNTY, MICH.
ANNE H. NORLANDER

For corners in
CALHOUN

(County)

Located In:

Corner Code #

- 1. Public Land Survey T 15 R 5 W A-10
- T _____ R _____
- T _____ R _____
- T _____ R _____
- 2. Property Controlling S _____ T _____ R _____
- in Section S _____ T _____ R _____
- 3. Miscellaneous S _____ T _____ R _____
- Property in Sec. S _____ T _____ R _____
- 4. Lot No. _____, Recorded Plat _____
- 5. Private Claims _____

Register of Deeds Stamp & File Number

I, DONALD J. DAVIS, in a field survey on SEPTEMBER 13, 1993, 19 93, do hereby certify that under requirements of P.A. 74, Michigan P.A. of 1970, the corner points mentioned in lines 1 and 2 above were in conformance with regulations and rules therefore as required in the current manual of survey instructions of the United States Department of the Interior, Bureau of Land Management or by a decree of a Court of Law and/or that the corner points mentioned in lines 3, 4 and 5 above were in conformance with the rules of the Michigan Board of Land Surveyors or by a Decree of a Court of Law; established, re-established, monumented, re-monumented, recovered, found as expressed below:

NOTE: Not more than 4 corners, all in the same town and range, may be recorded on this certificate.

A	B	C	D	E	F	G	H	I	J	K	L	M
2	6	5	4	3	2	1						
3												
4	7	8	9	10	11	12						
5												
6	13	17	16	15	14	13						
7												
8	19	20	21	22	23	24						
9												
10	30	29	28	27	26	25						
11												
12	31	32	33	34	35	36						
13												

A. Description of original monument and accessories and/or subsequent restoration:

CORNER NOT SET IN ORIGINAL OR RESURVEY BY GIFFORD IN 1891.
 CORNER ESTABLISHED BY J. KING IN FEBRUARY 1977 FROM PAROLE EVIDENCE AND PRIOR SURVEY BY ROGERS, RECORDED IN LIBER 1109, PAGE 853.
 CONCRETE MONUMENT PLACED.

LIBER 1707 PAGE 274


B. Description of corner evidence found and/or method applied in restoring or reestablishing corner:

FOUND CONCRETE MONUMENT AS CALLED FOR.

ACCEPTED THIS AS A TRUE CORNER ESTABLISHED BY LOCAL SURVEYORS TO MEET THE EVIDENCE AVAILABLE.

C. Description of monument for corner and accessories established to perpetuate locating the position of the corner:

- SET BERNISEN MONUMENT WITH BRASS CAP.
- NAIL & TAG 10" CHERRY S 10° E 5.58'.
- NAIL & TAG 10" CHERRY S 75° W 31.41'.
- NAIL & TAG 10" HICKORY S 20°W 14.45'.
- NAIL & TAG 12" ELM S 20° E 30.30'.
- 3" IRON POST WEST 31.0'.
- 4' SOUTH OF EAST & WEST FENCE.

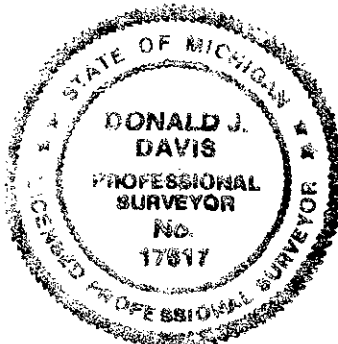

Signed by Donald J. Davis

Date SEPTEMBER 13, 1993.

Surveyor's Michigan License No. 17617