

SURVEY & REMONUMENTATION

APR 26 1995
CALHOUN COUNTY REMONUMENTATION

COMMISSION LAND CORNER RECORDATION CERTIFICATE Filing Requirement of Act 74, Mich. P.A. 1970

APPROVED
ate 10-19-94
**CALHOUN COUNTY
REMONUMENTATION.**
For corners in


<u>Calhoun</u> <small>(County)</small>	Located In:	Corner Code #	
1. Public Land Survey	T <u>1 S</u> R <u>5 W</u>	C-5	
	T _____ R _____	_____	
	T _____ R _____	_____	
	T _____ R _____	_____	
2. Property Controlling in Section	S _____ T _____ R _____	_____	
	S _____ T _____ R _____	_____	
3. Miscellaneous Property in Sec.	S _____ T _____ R _____	_____	
	S _____ T _____ R _____	_____	
4. Lot No. _____, Recorded Plat _____			
5. Private Claims _____			

STATE OF MICHIGAN
CALHOUN COUNTY
RECORDED

25 OCT 94 9:01 A.M.

ANNE B. NORLANDER
CLERK - REGISTER OF DEEDS
Register of Deeds Stamp & File Number

I, Donald J. Davis, in a field survey on August 10, 19 94, do hereby certify that under requirements of P.A. 74, Michigan P.A. of 1970, the corner points mentioned in lines 1 and 2 above were in conformance with regulations and rules therefore as required in the current manual of survey instructions of the United States Department of the Interior, Bureau of Land Management or by a decree of a Court of Law and/or that the corner points mentioned in lines 3, 4 and 5 above were in conformance with the rules of the Michigan Board of Land Surveyors or by a Decree of a Court of Law; established, re-established, monumented, re-monumented, recovered, found as expressed below:

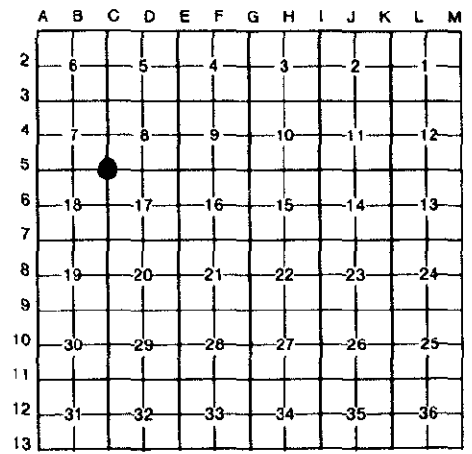


NOTE: Not more than 4 corners, all in the same town and range, may be recorded on this certificate.

A. Description of original monument and accessories and/or subsequent restoration:
Original survey of 1826.
Resurvey in 1891 by Gifford. Tile set.
Corner used and marked by Hatfield.
Tile destroyed by road construction.
Iron rod perpetuated by adjacent owners.

B. Description of corner evidence found and/or method applied in restoring or reestablishing corner:
Found 5/8" iron and rocks in road in line with fence North.
Accepted as location of corner as used on local surveys.

LIBER **1773** PAGE **879**

C. Description of monument for corner and accessories established to perpetuate locating the position of the corner:
Set Berntsen monument in monument box in bituminous road.
Nail & Tag 14" Oak S 5° E 45.50'
Nail & Tag 6" Cherry N 45° E 27.22'
Nail & Tag 10" Maple N 60° E 47.62'
Nail & Tag 12" Ash S 80° E 172.0'

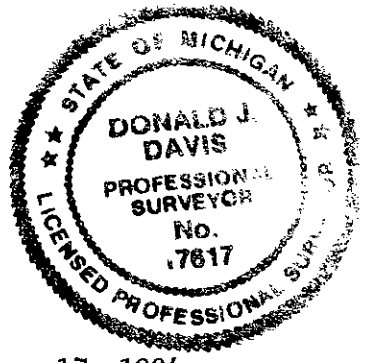

Signed by Donald J. Davis Date October 17, 1994
Surveyor's Michigan License No. 17617