

1993

REMONUMENTATION

RECORDED

COMMISSION

LAND CORNER RECORDATION CERTIFICATE
Filing Requirement of Act 74, Mich. P.A. 1970

OCT 6 9 48 AM '93

CLERK-REGISTER
CALHOUN COUNTY, MICH
ANNE B. NORLANDER

For corners in

CALHOUN

(County)

Located In:

Corner Code #

- 1. Public Land Survey T 1 S 5 R W C-10
T _____ R _____
T _____ R _____
T _____ R _____
- 2. Property Controlling S _____ T _____ R _____
in Section S _____ T _____ R _____
- 3. Miscellaneous S _____ T _____ R _____
Property in Sec. S _____ T _____ R _____

Register of Deeds Stamp & File Number

- 4. Lot No. _____, Recorded Plat _____
- 5. Private Claims _____

	A	B	C	D	E	F	G	H	I	J	K	L	M
2	6		5		4		3		2		1		
3													
4	7		8		9		10		11		12		
5													
6	18		17		16		15		14		13		
7													
8	19		20		21		22		23		24		
9													
10	30		29		28		27		26		25		
11													
12	31		32		33		34		35		36		
13													

I, DONALD J. DAVIS, in a field survey on SEPTEMBER 10, 19 93, do hereby certify that under requirements of P.A. 74, Michigan P.A. of 1970, the corner points mentioned in lines 1 and 2 above were in conformance with regulations and rules therefore as required in the current manual of survey instructions of the United States Department of the Interior, Bureau of Land Management or by a decree of a Court of Law and/or that the corner points mentioned in lines 3, 4 and 5 above were in conformance with the rules of the Michigan Board of Land Surveyors or by a Decree of a Court of Law; established, re-established, monumented, re-monumented, recovered, found as expressed below:

NOTE: Not more than 4 corners, all in the same town and range, may be recorded on this certificate.

A. Description of original monument and accessories and/or subsequent restoration:

- TILE SET IN RESURVEY OF 1891 BY GIFFORD.
- 8" BASSWOOD S 52½° W 18 LINKS.
- 6" ELM N 27° W 12 LINKS.
- 5/8" IRON SET BY KING IN 1973 BY PROPORTION, RECORDED IN LIBER 1039, PAGE 440.

B. Description of corner evidence found and/or method applied in restoring or reestablishing corner:


FOUND 5/8" IRON ON CENTERLINE OF ROAD IN LINE WITH FENCE WEST.

ACCEPTED THIS CORNER AS LOCAL REESTABLISHMENT OF CORNER LOCATION.

LIBER 1707 PAGE 277

C. Description of monument for corner and accessories established to perpetuate locating the position of the corner:

- SET BERNTSEN MONUMENT WITH BRASS CAP IN MONUMENT BOX.
- NAIL & TAG 8" CEDAR N 20° E 56.82'.
- NAIL & TAG 16" CHESTNUT S 70° W 45.56'.
- NAIL & TAG 26" OAK S 25° W 106.82'.
- NAIL & TAG TWIN 10" CHESTNUT S 40° W 52.86'.

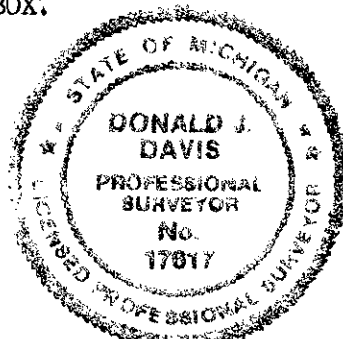

Signed by Donald J. Davis

Date SEPTEMBER 15, 1993

Surveyor's Michigan License No. 17617