

APPROVED
 Date 4-20-94
CALHOUN COUNTY
REMONUMENTATION.

SURVEY &
REMONUMENTATION
 OCT 27 1994
COMMISSION

CALHOUN COUNTY REMONUMENTATION
LAND CORNER RECORDATION CERTIFICATE
Filing Requirement of Act 74, Mich. P.A. 1970

For corners in
Calhoun
 (County)

Public Land Survey	T <u>1S</u> R <u>5W</u>	<u>C-12</u>
	T _____ R _____	_____
	T _____ R _____	_____
	T _____ R _____	_____
Property Controlling in Section	S _____ T _____ R _____	_____
	S _____ T _____ R _____	_____
Miscellaneous Property in Sec.	S _____ T _____ R _____	_____
	S _____ T _____ R _____	_____

STATE OF MICHIGAN
 CALHOUN COUNTY
 RECORDED
 25 APR 94 12:19 P.M.
 ANNE B. NORLANDER
 CLERK - REGISTER OF DEEDS

Register of Deeds Stamp & File Number

Lot No. _____, Recorded Plat _____
 Private Claims _____

Donald J. Davis, in a field survey on April 16, 1994,
 hereby certify that under requirements of P.A. 74, Michigan P.A. of 1970, the corner points mentioned
 in lines 1 and 2 above were in conformance with regulations and rules therefore as required in the
 current manual of survey instructions of the United States Department of the Interior, Bureau of Land
 Management or by a decree of a Court of Law and/or that the corner points mentioned in lines 3, 4 and 5
 above were in conformance with the rules of the Michigan Board of Land Surveyors or by a Decree of a
 Court of Law; established, re-established, monumented, re-monumented, recovered, found as
 expressed below:

A	B	C	D	E	F	G	H	I	J	K	L	M
2	6	5	4	3	2	1						
3												
4	7	8	9	10	11	12						
5												
6	18	17	16	15	14	13						
7												
8	19	20	21	22	23	24						
9												
10	30	29	28	27	26	25						
11												
12	31	32	33	34	35	36						
13												

NOTE: Not more than 4 corners, all in the same town and range, may be recorded on this certificate.


Description of original monument and accessories and/or subsequent restoration:
 Tile set in resurvey by Gifford in 1891. Found 1" iron pipe in centerline of road.
 10" Elm S 88° E 90 links. Gate Post West 23.0' (gone)
 10" Elm S 86½° W 67 links. Utility Pole East 21.8' (gone)
 30" Oak S 86° E 99.2' (gone)

Description of corner evidence found and/or method applied in restoring or reestablishing corner:
 Found 1" iron pipe in centerline of road.

Accepted as perpetuation of corner.

LIBER **1743** PAGE **588**

Description of monument for corner and accessories established to perpetuate locating the position of the corner:
 Set Bernsten monument in monument box.
 Nail & Tag RR tie Post West 24.05'
 Nail & Tag Box Elder N 35° W 55.40'
 Nail & Tag Corner Post East 21.95'
 Nail & Tag Utility Pole S 60° E 125.70'

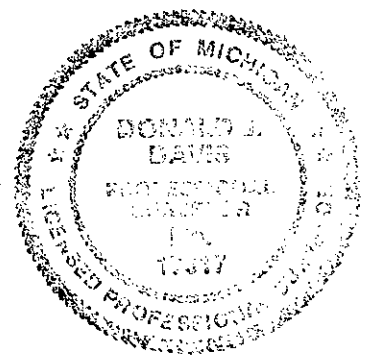

Signed by Donald J. Davis Date April 20, 1994
 Surveyor's Michigan License No. 17617