

OCT 27 1994

COMMISSION

STATE OF MICHIGAN  
CALHOUN COUNTY  
RECORDED

25 APR 94 12:19 P.M.

ANNE B. NORLANDER  
CLERK - REGISTER OF DEEDS

Register of Deeds Stamp & File Number

**APPROVED**  
Date 4-20-94 DJD  
**CALHOUN COUNTY  
REMONUMENTATION.**

CALHOUN COUNTY REMONUMENTATION

**LAND CORNER RECORDATION CERTIFICATE**  
Filing Requirement of Act 74, Mich. P.A. 1970

or corners in  
Calhoun \_\_\_\_\_ Located In: \_\_\_\_\_ Corner Code ≠ \_\_\_\_\_  
(County)

Public Land Survey T 1S R 5W \_\_\_\_\_ C-13  
T \_\_\_\_\_ R \_\_\_\_\_  
T \_\_\_\_\_ R \_\_\_\_\_  
T \_\_\_\_\_ R \_\_\_\_\_

Property Controlling S \_\_\_\_\_ T \_\_\_\_\_ R \_\_\_\_\_  
in Section S \_\_\_\_\_ T \_\_\_\_\_ R \_\_\_\_\_

Miscellaneous S \_\_\_\_\_ T \_\_\_\_\_ R \_\_\_\_\_  
Property in Sec. S \_\_\_\_\_ T \_\_\_\_\_ R \_\_\_\_\_

Lot No. \_\_\_\_\_, Recorded Plat \_\_\_\_\_  
Private Claims \_\_\_\_\_

	A	B	C	D	E	F	G	H	I	J	K	L	M
2	6		5		4		3		2				
3													
4	7		8		9		10		11		12		
5													
6	18		17		16		15		14		13		
7													
8	19		20		21		22		23		24		
9													
10	30		29		28		27		26		25		
11													
12	31		32		33		34		35		36		
13													

Donald J. Davis in a field survey on April 16, 1994,  
I hereby certify that under requirements of P.A. 74, Michigan P.A. of 1970, the corner points mentioned  
in lines 1 and 2 above were in conformance with regulations and rules therefore as required in the  
current manual of survey instructions of the United States Department of the Interior, Bureau of Land  
Management or by a decree of a Court of Law and/or that the corner points mentioned in lines 3, 4 and 5  
above were in conformance with the rules of the Michigan Board of Land Surveyors or by a Decree of a  
Court of Law; established, re-established, monumented, re-monumented, recovered, found as  
expressed below:

**NOTE: Not more than 4 corners, all in the same town and range, may be recorded  
on this certificate.**

Description of original monument and accessories and/or subsequent restoration:  
Iron in blacktop by DeKeyser in 1970  
Tile set in resurvey by Gifford in 1891 East of Marengo corner. Corner fence post N 15° W 94.05'  
20" Hickory N 76° E 187 links. 12" Hickory N 45° W 41.25'  
Centerline of roads North-East-West. P.K. Nail in Utility pole N 45° E 47.2'  
Spotter in Utility pole N 10° W 95.1'

Davis 1974  
Found 1" pipe in bituminous  
10" Hickory N 45° E 41.18'  
RR tie Post South 37.47'  
Centerline Road North

Description of corner evidence found and/or method applied in restoring or reestablishing corner:


Found 3/4" pipe with tile around bottom, checked with old witnesses.  
10" Hickory N 45° E 41.25'  
RR Tie Post South 37.47'

Accepted as true perpetuation of original corner.

LIBER 1743 PAGE 589

Description of monument for corner and accessories established to perpetuate locating the position of the corner:

Set Berntsen monument in monument box.  
Nail & Spotter 18" Hickory N 45° E 41.21'  
Nail & Spotter RR Tie S 10° E 37.40'  
Nail & Spotter Utility pole N 15° E 140.35'  
NE corner of telephone station S 50° W 80.35'

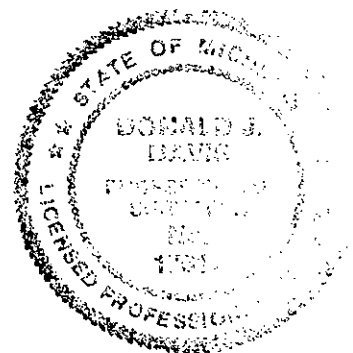

Signed by Donald J. Davis  
Surveyor's Michigan License No. 17617

Date April 20, 1994