

SURVEY & REMONUMENTATION

APR 26 1995
CALHOUN COUNTY REMONUMENTATION

LAND CORNER RECORDATION CERTIFICATE Filing Requirement of Act 74, Mich. P.A. 1970

APPROVED

Date 10-19-94
CALHOUN COUNTY
REMONUMENTATION
For corners in

Calhoun <small>(County)</small>	Located In:	Corner Code <u>##</u>	
1. Public Land Survey	T <u>1</u> S <u>5</u> R <u>5</u> W	<u>D-3</u>	
	T _____ R _____	_____	
	T _____ R _____	_____	
	T _____ R _____	_____	
2. Property Controlling in Section	S _____ T _____ R _____	_____	
	S _____ T _____ R _____	_____	
3. Miscellaneous Property in Sec.	S _____ T _____ R _____	_____	
	S _____ T _____ R _____	_____	
4. Lot No. _____, Recorded Plat _____			
5. Private Claims _____			

STATE OF MICHIGAN
CALHOUN COUNTY
RECORDED

25 OCT 94 9:01 A.M.

ANNE B. NORLANDER
Register of Deeds Stamp & File Number

I, Donald J. Davis, in a field survey on August 10, 1994, do hereby certify that under requirements of P.A. 74, Michigan P.A. of 1970, the cornerpoints mentioned in lines 1 and 2 above were in conformance with regulations and rules therefore as required in the current manual of survey instructions of the United States Department of the Interior, Bureau of Land Management or by a decree of a Court of Law and/or that the corner points mentioned in lines 3, 4 and 5 above were in conformance with the rules of the Michigan Board of Land Surveyors or by a Decree of a Court of Law; established, re-established, monumented, re-monumented, recovered, found as expressed below:

NOTE: Not more than 4 corners, all in the same town and range, may be recorded on this certificate.

	A	B	C	D	E	F	G	H	I	J	K	L	M
2	6		5		4		3		2		1		
3			●										
4	7		8		9		10		11		12		
5													
6	18		17		16		15		14		13		
7													
8	19		20		21		22		23		24		
9													
10	30		29		28		27		26		25		
11													
12	31		32		33		34		35		36		
13													

A. Description of original monument and accessories and/or subsequent restoration:

Original survey in 1826.
Resurvey in 1891 by Gifford. Tile Set.
Iron set by Wilcox in 1981 from 1891 witnesses,
Recorded in Liber 1243, page 719.
8" Ash N 41° E 32.86'
Power Pole N 26° W 45.77'
Power Pole S 18° E 36.92'


B. Description of corner evidence found and/or method applied in restoring or reestablishing corner:

Found iron rod in bituminous road. Iron checks with Wilcox L.C.R.C.
Accepted as good corner location.

LIBER 1773 PAGE 880

C. Description of monument for corner and accessories established to perpetuate locating the position of the corner:

Set Berntsen monument with monument box in bituminous surface.
Nail & Tag Utility Pole N 26° W 45.70'
Nail & Tag Utility Pole S 20° E 36.75'
Nail & Tag 14" Ash N 50° E 32.40'
Nail & Tag 50" Poplar S 60° E 79.00'

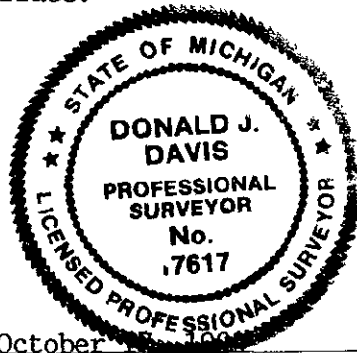

Signed by Donald J. Davis Date October 19, 1994
Surveyor's Michigan License No. 17617