

SURVEY & REMONUMENTATION

APR 26 1995

CALHOUN COUNTY REMONUMENTATION

COMMISSION

LAND CORNER RECORDATION CERTIFICATE

Filing Requirement of Act 74, Mich. P.A. 1970

APPROVED

Date 10-19-94

**CALHOUN COUNTY
REMONUMENTATION.**

For corners in

Calhoun

(County)

Located In:

Corner Code ≠

- | | | |
|---------------------------------------|---------------------------|------------|
| 1. Public Land Survey | T <u>1</u> S R <u>5</u> W | <u>E-4</u> |
| | T _____ R _____ | _____ |
| | T _____ R _____ | _____ |
| | T _____ R _____ | _____ |
| 2. Property Controlling
in Section | S _____ T _____ R _____ | _____ |
| | S _____ T _____ R _____ | _____ |
| 3. Miscellaneous
Property in Sec. | S _____ T _____ R _____ | _____ |
| | S _____ T _____ R _____ | _____ |
| 4. Lot No. _____, Recorded Plat _____ | | |
| 5. Private Claims _____ | | |

STATE OF MICHIGAN
CALHOUN COUNTY
RECORDED
Register of Deeds Stamp & File Number
25 OCT 94 9:00 A.M.

	A	B	C	D	E	F	G	H	I	J	K	L	M
2	6												
3													
4	7												
5													
6	18												
7													
8	19												
9													
10	30												
11													
12	31												
13													

Donald J. Davis, in a field survey on August 10, 1994, do hereby certify that under requirements of P.A. 74, Michigan P.A. of 1970, the corner points mentioned in lines 1 and 2 above were in conformance with regulations and rules therefore as required in the current manual of survey instructions of the United States Department of the Interior, Bureau of Land Management or by a decree of a Court of Law and/or that the corner points mentioned in lines 3, 4 and 5 above were in conformance with the rules of the Michigan Board of Land Surveyors or by a Decree of a Court of Law; established, re-established, monumented, re-monumented, recovered, found as expressed below:


NOTE: Not more than 4 corners, all in the same town and range, may be recorded on this certificate.

A. Description of original monument and accessories and/or subsequent restoration:
Original survey in 1826.
Resurvey in 1891 by Gifford, tile set.
Corner reset by Wilcox in 1981. Corner falls in 54" Oak.
Witness iron set 3.1' South of true corner.
Recorded in LCRC Liber 1243, page 719.

B. Description of corner evidence found and/or method applied in restoring or reestablishing corner:
Found iron in root of 54" Oak as called for in L.C.R.C. for 3.1' South, found 5/8" iron 15' South as called for by Wilcox in L.C.R.C. Liber 1243, page 719.
Accepted as a good location for corner witnesses.

LIBER **1773** PAGE **875**

C. Description of monument for corner and accessories established to perpetuate locating the position of the corner:
Marked irons and included location in traverse of Section 8.
Corner is located S 00°-39'-36" W 2637.64 feet from NE corner of Section.
Bearing on North line of Northeast ¼ is N 89°-21'-43" E.
No other trees near.

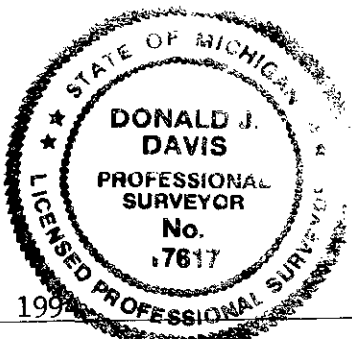

Signed by Donald J. Davis Date October 17, 1994
Surveyor's Michigan License No. 17617