

APPROVED

Date 11-12-96
CALHOUN COUNTY
REMONUMENTATION.

CALHOUN COUNTY REMONUMENTATION
LAND CORNER RECORDATION CERTIFICATE
Filing Requirement of Act 74, Mich. P.A. 1970

STATE OF MICHIGAN
CALHOUN COUNTY
RECORDED

19 FEB 97 3:47 P.M.

ANNE D. NORLANDER
CLERK - REGISTER OF DEEDS

LIBER 1916 PAGE 103

Register of Deeds Stamp & File Number


For corners in

<u>Calhoun</u> (County)	Located in:	Corner Code #
Lee Township	<u>T 1 S R 5 W</u>	<u>F-7</u>
1. Public Land Survey	T ___ R ___	_____
	T ___ R ___	_____
	T ___ R ___	_____
2. Property Controlling in Section	S ___ T ___ R ___	_____
	S ___ T ___ R ___	_____
3. Miscellaneous Property in Sec.	S ___ T ___ R ___	_____
	S ___ T ___ R ___	_____

4. Lot No. _____, Recorded Plat _____
5. Private Claims _____

I, William K. Crane, in a field survey on November 8, 1996 do hereby state that under requirements of P.A. 74, Michigan P.A. of 1970, the corner points mentioned in lines 1 and 2 above were in conformance with regulations and rules therefore as required in the current manual of survey instructions of the United States Department of the Interior, Bureau of Land Management or by a decree of a Court of Law and for that the corner points mentioned in lines 3, 4 and 5 above were in conformance with the rules of the Michigan Board of Land Surveyors or by a Decree of a Court of Law, established, re-established, monumented, recovered, found as expressed below.

NOTE: Not more than 2 corners, all in the same town and range, may be recorded on this certificate.

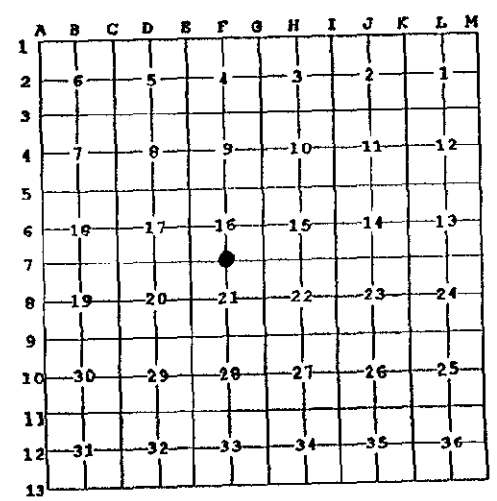

A. Description of original monument and accessories and/or subsequent restoration:

Original Government Survey, Sylvester Sibley, 1826:
Set quarter post at average distance from which no bearing were taken. Raised a mound.

Resurvey, James Gifford, 1892:
Set stake at average distance. Center of East and West town ditch is 10 links North. West to center of ditch running North 7 links.

B. Description of corner evidence found and/or method applied in restoring or reestablishing corner:

No other history of corner location was found. Area is built up for road running thru muck fields. Established corner location at intersection of line running from the Southeast corner thru the centerline of the East and West road near South 1/4 corner and a line running from the North 1/4 corner thru the centerline of the North and South road near the center of section. I believe the physical evidence described above to be the best available evidence for the location of the corner due to the conditions in the area.

C. Description of monument for corner and accessories established to perpetuate locating the position of the corner:

Set Calhoun County Remonumentation Monument (Berntsen Monument) in monument box at location described above..


- Sign Post.....N88°W.....571.29'
- SE Corner Section 16.....East.....2643.82'
- N 1/4 Corner Section 16.....North.....5301.90'
- Capped iron #29243.....N45°E.....71.92'
- Capped iron #29243.....S45°E.....45.13'
- Capped iron #29243.....S45°W.....40.0'

This is accepted as the best available evidence of the position of the original corner.

Signed by William K. Crane
William K. Crane, P.S.

Date January 31, 1997

Surveyor's Michigan License No. 29243
SURVEY &
REMONUMENTATION

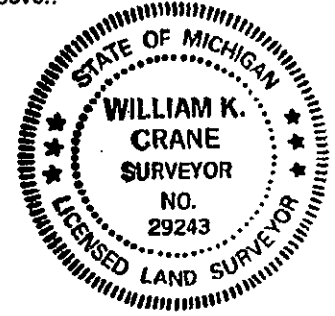

APR 07 1998

SECTION