

APPROVED

Date 11-12-96
CALHOUN COUNTY
REMONUMENTATION.

CALHOUN COUNTY REMONUMENTATION
LAND CORNER RECORDATION CERTIFICATE
Filing Requirement of Act 74, Mich. P.A. 1970

STATE OF MICHIGAN
CALHOUN COUNTY
RECORDED

19 FEB 97 3:48 P.M.

ANNE B. NORLANDER
CLERK - REGISTER OF DEEDS

LIBER 1916 PAGE 104

Register of Deeds Stamp & File Number

For corners in

Calhoun
(County)

Located In:

Corner Code #

Lee Township
1. Public Land Survey

T 1 S R 5 W

G-5

T R

T R

T R

2. Property Controlling
in Section

S T R

3. Miscellaneous
Property in Sec.

S T R

S T R

S T R

4. Lot No. _____, Recorded Plat _____

5. Private Claims _____

I, William K. Crane, in a field survey on November 8, 1996 do hereby state that under requirements of P.A. 74, Michigan P.A. of 1970, the corner points mentioned in lines 1 and 2 above were in conformance with regulations and rules therefore as required in the current manual of survey instructions of the United States Department of the Interior, Bureau of Land Management or by a decree of a Court of Law and for that the corner points mentioned in lines 3, 4 and 5 above were in conformance with the rules of the Michigan Board of Land Surveyors or by a Decree of a Court of Law, established, re-established, monumented, recovered, found as expressed below.

NOTE: Not more than 2 corners, all in the same town and range, may be recorded on this certificate.

A. Description of original monument and accessories and/or subsequent restoration:

Original Government Survey, Sylvester Sibley, 1826:

7" Lynn.....S70°W.....35 links

9" W. Ash.....S67°E.....18 links

Resurvey, James Gifford, 1892:

Found stone in place planted by former surveyor when the stumps of the government bearing trees were in existence. Set stake.

8" Hickory.....S47°E.....84 links

14" D.O.....N88-1/2°E.....33 links

Corner recorded by J.L. Wilcox, January 30, 1981, Liber 1243, Page 718

found red clay tile in rock pile, raised with rerod and cap.:

18" Hickory.....S43-1/2°E.....56.18'

22" Hickory.....S60°E.....49.50'

15" Hickory.....S25°E.....86.21'

B. Description of corner evidence found and/or method applied in restoring or reestablishing corner:

Found 1/2" iron over tile as described in LCRC in Liber 1243, Page 718.
7.5' North of East and West centerline, 5.5' West of North and South centerline.

C. Description of monument for corner and accessories established to perpetuate locating the position of the corner:

Replaced 1/2" iron and first tile with Standard Calhoun County Remonumentation Monument (Bemtsen Monument) over second tile. Placed in monument box.

Set PK Nail.....West side of U. pole.....N11-1/2°W.....126.0'

Set PK Nail.....NW side of U. pole.....N54-1/2°E.....189.82'

Set Nail & spotter.....SW side of 16" Hickory.....S46-1/2°E.....55.86'

Set Nail & spotter.....East side of 24" Hickory.....S5-1/2°W.....246.14'

This is accepted as careful and faithful perpetuation of the position of the original corner.

Signed by William K. Crane

William K. Crane, P.S.

Date January 31, 199


Surveyor's Michigan License No. 29243

SURVEY &
REMONUMENTATION

APR 07 1998

SECTION

	A	B	C	D	E	F	G	H	I	J	K	L	M
1													
2	6	5											
3													
4	7	9											
5													
6	18	17											
7													
8	19	20											
9													
10	30	29											
11													
12	31	32											
13													

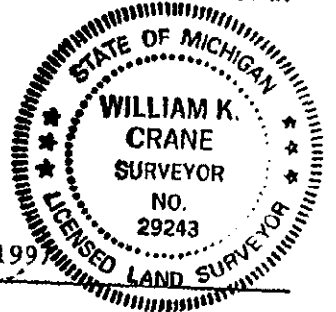

FORM APPROVED BY MICHIGAN STATE BOARD OF PROFESSIONAL SURVEYORS, JAN 28, 1971
REVISED MAY 14, 1978
REVISED JAN, 1983
REVISED OCT., 1985